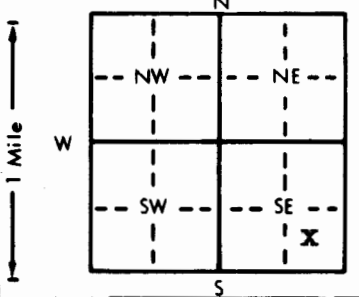


1 LOCATION OF WATER WELL: Fraction NW 1/4 SE 1/4 SE 1/4 Section Number 22 Township Number T 34 S Range Number R 10 EW  
 County: Barber  
 Distance and direction from nearest town or city street address of well if located within city?  
3 1/2 N 1 1/2 W Kiowa

2 WATER WELL OWNER: Paul Diel  
 RR#, St. Address, Box #: Burlington, okla 73722 Board of Agriculture, Division of Water Resources  
 City, State, ZIP Code: Application Number:

3 LOCATE WELL'S LOCATION WITH AN "X" IN SECTION BOX:  
  
 4 DEPTH OF COMPLETED WELL: 36 ft. ELEVATION:  
 Depth(s) Groundwater Encountered 1. 18 ft. 2. ft. 3. ft.  
 WELL'S STATIC WATER LEVEL 6 ft. below land surface measured on mo/day/yr 4-19-89  
 Pump test data: Well water was ft. after hours pumping gpm  
 Est. Yield 10 gpm: Well water was ft. after hours pumping gpm  
 Bore Hole Diameter: 8 in. to 36 ft., and in. to ft.  
 WELL WATER TO BE USED AS:  
 5 Public water supply 8 Air conditioning 11 Injection well  
 1 Domestic 3 Feedlot 6 Oil field water supply 9 Dewatering 12 Other (Specify below)  
 2 Irrigation 4 Industrial 7 Lawn and garden only 10 Monitoring well  
 Was a chemical/bacteriological sample submitted to Department? Yes No; If yes, mo/day/yr sample was submitted  
 Water Well Disinfected? Yes No

5 TYPE OF BLANK CASING USED:  
 1 Steel 3 RMP (SR) 5 Wrought iron 8 Concrete tile CASING JOINTS: Glued Clamped  
 2 PVC 4 ABS 6 Asbestos-Cement 9 Other (specify below) Welded  
 7 Fiberglass Threaded  
 Blank casing diameter 4 in. to 13 ft., Dia 4 in. to 32 ft., Dia in. to ft.  
 Casing height above land surface 16 in., weight lbs./ft. Wall thickness or gauge No. .187  
 TYPE OF SCREEN OR PERFORATION MATERIAL:  
 1 Steel 3 Stainless steel 5 Fiberglass 7 PVC 10 Asbestos-cement  
 2 Brass 4 Galvanized steel 6 Concrete tile 8 RMP (SR) 11 Other (specify)  
 9 ABS 12 None used (open hole)  
 SCREEN OR PERFORATION OPENINGS ARE:  
 1 Continuous slot 3 Mill slot 5 Gauzed wrapped 8 Saw cut 11 None (open hole)  
 2 Louvered shutter 4 Key punched 6 Wire wrapped 9 Drilled holes  
 7 Torch cut 10 Other (specify)  
 SCREEN-PERFORATED INTERVALS: From 12 ft. to 18 ft., From 32 ft. to 34 ft.  
 From ft. to ft., From ft. to ft.  
 GRAVEL PACK INTERVALS: From 12 ft. to 36 ft., From ft. to ft.  
 From ft. to ft., From ft. to ft.

6 GROUT MATERIAL: 1 Neat cement 2 Cement grout 3 Bentonite 4 Other  
 Grout Intervals: From 0 ft. to 12 ft., From ft. to ft., From ft. to ft.  
 What is the nearest source of possible contamination:  
 1 Septic tank 4 Lateral lines 7 Pit privy 10 Livestock pens 14 Abandoned water well  
 2 Sewer lines 5 Cess pool 8 Sewage lagoon 11 Fuel storage 15 Oil well/Gas well  
 3 Watertight sewer lines 6 Seepage pit 9 Feedyard 12 Fertilizer storage 16 Other (specify below)  
 13 Insecticide storage  
 Direction from well? N How many feet? 300

FROM	TO	LITHOLOGIC LOG	FROM	TO	PLUGGING INTERVALS
0	5	soil			
5	12	fine sand			
12	18	med to fine sand			
18	32	clay and mud			
32	34	med sand			
34	36	shale			
		Well not grouted to total depth because of formation			

**RECEIVED**  
 MAY 8 1989  
 DIVISION OF ENVIRONMENT

7 CONTRACTOR'S OR LANDOWNER'S CERTIFICATION: This water well was (1) constructed, (2) reconstructed, or (3) plugged under my jurisdiction and was completed on (mo/day/year) 4-19-89 and this record is true to the best of my knowledge and belief. Kansas Water Well Contractor's License No. 140 This Water Well Record was completed on (mo/day/yr) 5-4-89 under the business name of Lyman Inc. by (signature) Paul Diel