

1 LOCATION OF WATER WELL: Fraction SW 1/4 SW 1/4 Section Number 6 Township Number T 34 S Range Number R 11 E (N)
 County: Barber

Distance and direction from nearest town or city street address of well if located within city?


11 miles south of Medicine Lodge

2 WATER WELL OWNER: Barber Co. Solid Waste Landfill

RR#, St. Address, Box # :
 City, State, ZIP Code :

Board of Agriculture, Division of Water Resources
 Application Number:

3 LOCATE WELL'S LOCATION WITH AN "X" IN SECTION BOX:

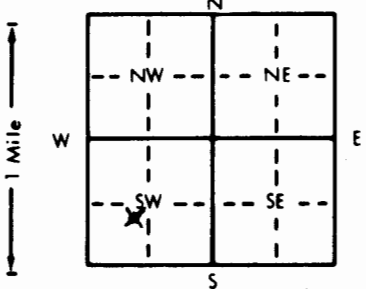

4 DEPTH OF COMPLETED WELL: 20 ft. ELEVATION:

Depth(s) Groundwater Encountered 1. 5 ft. 2. ft. 3. ft.

WELL'S STATIC WATER LEVEL 5.0 ft. below land surface measured on mo/day/yr 3/11/98

Pump test data: Well water was ft. after hours pumping gpm

Est. Yield gpm: Well water was ft. after hours pumping gpm

Bore Hole Diameter 8 in. to 20 ft., and in. to ft.

WELL WATER TO BE USED AS: 5 Public water supply 8 Air conditioning 11 Injection well

1 Domestic 3 Feedlot 6 Oil field water supply 9 Dewatering 12 Other (Specify below)

2 Irrigation 4 Industrial 7 Lawn and garden only 10 Monitoring well

Was a chemical/bacteriological sample submitted to Department? Yes No If yes, mo/day/yr sample was submitted

Water Well Disinfected? Yes No

5 TYPE OF CASING USED:

- 1 Steel
- 2 PVC
- 3 RMP (SR)
- 4 ABS
- 5 Wrought iron
- 6 Asbestos-Cement
- 7 Fiberglass
- 8 Concrete tile
- 9 Other (specify below)
- 10 Asbestos-cement
- 11 Other (specify)
- 12 None used (open hole)

CASING JOINTS: Glued Clamped Welded Threaded

Blank casing diameter 2 in. to 5 ft., Dia in. to ft., Dia in. to ft.

Casing height above land surface 34 in., weight lbs./ft. Wall thickness or gauge No. Sch 40

TYPE OF SCREEN OR PERFORATION MATERIAL:

- 1 Steel
- 2 Brass
- 3 Stainless steel
- 4 Galvanized steel
- 5 Fiberglass
- 6 Concrete tile
- 7 PVC
- 8 RMP (SR)
- 9 ABS
- 10 Asbestos-cement
- 11 Other (specify)
- 12 None used (open hole)

SCREEN OR PERFORATION OPENINGS ARE:

- 1 Continuous slot
- 2 Louvered shutter
- 3 Mill slot
- 4 Key punched
- 5 Gauzed wrapped
- 6 Wire wrapped
- 7 Torch cut
- 8 Saw cut
- 9 Drilled holes
- 10 Other (specify)
- 11 None (open hole)

SCREEN-PERFORATED INTERVALS: From 5 ft. to 20 ft., From ft. to ft., From ft. to ft., From ft. to ft.

GRAVEL PACK INTERVALS: From 2.5 ft. to 20 ft., From ft. to ft., From ft. to ft., From ft. to ft.

6 GROUT MATERIAL: 1 Neat cement 2 Cement grout 3 Bentonite 4 Other

Grout Intervals: From 0 ft. to 2.5 ft., From ft. to ft., From ft. to ft., From ft. to ft.

What is the nearest source of possible contamination:

- 1 Septic tank
- 2 Sewer lines
- 3 Watertight sewer lines
- 4 Lateral lines
- 5 Cess pool
- 6 Seepage pit
- 7 Pit privy
- 8 Sewage lagoon
- 9 Feedyard
- 10 Livestock pens
- 11 Fuel storage
- 12 Fertilizer storage
- 13 Insecticide storage
- 14 Abandoned water well
- 15 Oil well/Gas well
- 16 Other (specify below) Landfill

Direction from well? West How many feet? 100

FROM	TO	LITHOLOGIC LOG	FROM	TO	PLUGGING INTERVALS
0	0.5	Topsoil, Light Brown			
0.5	6.0	SILT, sandy, moderate brown, fine sand, low plasticity, damp			
6.0	18.0	SAND, silty, moderate brown, very fine grained, low plasticity, saturated			
18.0	20.0	SHALE, weathered, moderate brown, silty sandy, with grey flacks, dry			
		MW-2A			

7 CONTRACTOR'S OR LANDOWNER'S CERTIFICATION: This water well was (1) constructed, (2) reconstructed, or (3) plugged under my jurisdiction and was completed on (mo/day/year) 3/11/98 and this record is true to the best of my knowledge and belief. Kansas

Water Well Contractor's License No. 524 This Water Well Record was completed on (mo/day/yr) 3/27/98

under the business name of Allied Laboratories by (signature) R. Brownell