

WATER WELL RECORD

Form WWC-5

Division of Water Resources App. No.


Blank box for application number

1 LOCATION OF WATER WELL: County: Barber, Fraction: 1/4 NE 1/4 NE 1/4 SE 1/4, Section Number: 3, Township No. T 34 S, Range Number R 11 E X W

Street/Rural Address of Well Location; if unknown, distance & direction from nearest town or intersection: Approximately 7 miles north and 1 mile west of Kiowa.

Global Positioning System (GPS) information: Latitude: 37.115335, Longitude: -98.495369, Elevation: unknown, Datum: WGS 84, NAD 83, NAD 27, Collection Method: GPS unit (Make/Model: WAAS)

2 WATER WELL OWNER: Brent Diel, RR#, Street Address, Box #: 212 Coates, City, State, ZIP Code: Kiowa, KS 67070

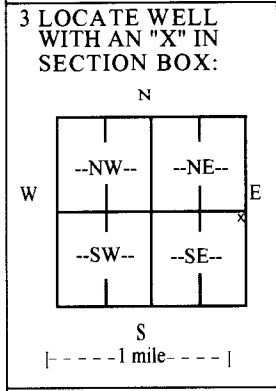

3 LOCATE WELL WITH AN 'X' IN SECTION BOX: 4 DEPTH OF COMPLETED WELL: 41 ft. Depth(s) Groundwater Encountered (1) 16.85 ft. (2) ft. (3) ft. WELL'S STATIC WATER LEVEL 16.85 ft. below land surface measured on mo/day/yr 8/24/11

5 TYPE OF CASING USED: Steel, PVC, Other. CASING JOINTS: Glued, Clamped, Welded, Threaded. Casing diameter 5 in. to 21 ft., Diameter 5 in. to 41 ft., Diameter in. to ft. Casing height above land surface 24 in., Weight 2.36 lbs./ft., Wall thickness or gauge No. 214

6 GROUT MATERIAL: Neat cement, Cement grout, Bentonite, Other. Grout Intervals: From ft. to ft., From 0 ft. to 20 ft., From ft. to ft. What is the nearest source of possible contamination: Septic tank, Lateral lines, Pit privy, Livestock pens, Insecticide storage, Other (specify below)

Table with columns: FROM, TO, LITHOLOGIC LOG, FROM, TO, LITHO. LOG (cont.) or PLUGGING INTERVALS. Rows: 0-2 Topsoil, 2-21 Clay, brown, 21-31 Sand, gravel, fine to coarse, 31-41 Shale, red

7 CONTRACTOR'S OR LANDOWNER'S CERTIFICATION: This water well was constructed, reconstructed, or plugged under my jurisdiction and was completed on (mo/day/year) 8/24/11 and this record is true to the best of my knowledge and belief.

INSTRUCTIONS: Use typewriter or ball point pen. PLEASE PRESS FIRMLY and PRINT clearly. Please fill in blanks and check the correct answers. Send three copies (white, blue, pink) to Kansas Department of Health and Environment, Bureau of Water, Geology Section, 1000 SW Jackson St., Suite 420, Topeka, Kansas 66612-1367.