


12890 SE Hwy 281 – Kiowa

Application Number:

4 DEPTH OF COMPLETED WELL **45.3** ft. ELEVATION:

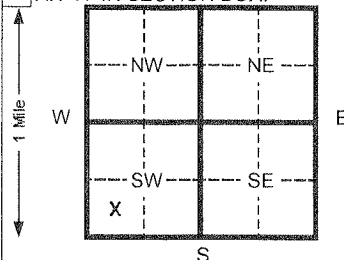

submitted Water Well Disinfected? Yes No **X**

FROM	TO	FROM	TO
1. Cement	2. Cement	3. Portland	4. Other

How many feet?

[illegible]

by (signature) _____

