20341

USE TYPEWRITER OR BALL POINT PEN-PRESS FIRMLY, PRINT CLEARLY.

WATER WELL RECORD
KSA 82a-1201-1215

Kansas Department of Health and Environment-Division of Environment
(Water well Contractors)
Topeka, Kansas 66620

1. Location of well:	County: Barber	Fraction: nw 1/4 nw 1/4 se 1/4	Section number: 20	Township number: T 34 S	Range number: R 11 E/W X

X Distance and direction from nearest town or city: 1/2 ?
Street address of well location if in city: 2n 3-3/4 w Kiowa

3. Owner of well: Ruby Willig
R.R. or street:
City, state, zip code: Kiowa, Ks.

4. Locate with "X" in section below:

Sketch map:

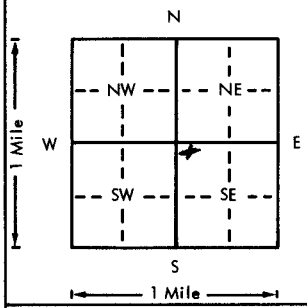

5. Type and color of material	From	To
soil	0	8
shale	8	47

(Use a second sheet if needed)

6. Bore hole dia. 9 in. Completion date 12-15-77
Well depth 47 ft.

7. __ Cable tool X Rotary __ Driven __ Dug
__ Hollow rod __ Jetted __ Bored __ Reverse rotary

8. Use: __ Domestic __ Public supply __ Industry
__ Irrigation __ Air conditioning X Stock
__ Lawn __ Oil field water __ Other

9. Casing: Material ____ Height: Above or below
Threaded ____ Welded ____ Surface 22 in.
RMP ____ PVC X Weight 292 lbs./ft.
Dia. 5 in. 47 ft. depth Wall Thickness: inches or
Dia. ____ in. to ____ ft. depth gage No. 258

10. Screen: Manufacturer's name Peerless
Type pvc Dia. 5
Slot/gauze 035 Length 10
Set between 37 ft. and 47 ft.
____ ft. and ____ ft.
Gravel pack? X Size range of material 1/2 dn

11. Static water level: mo./day/yr.
18 ft. below land surface Date 12-15-77

12. Pumping level below land surfaces:
____ ft. after ____ hrs. pumping ____ g.p.m.
____ ft. after ____ hrs. pumping ____ g.p.m.
Estimated maximum yield 4 g.p.m.

13. Water sample submitted: mo./day/yr.
__ Yes X No Date

14. Well head completion:
__ Pitless adapter 24 Inches above grade

15. Well grouted? X
With: __ Neat cement __ Bentonite __ Concrete
Depth: From 0 ft. to 12 ft.

16. Nearest source of possible contamination:
ft. 10 Direction W Type overflow
Well disinfected upon completion? X Yes __ No

17. Pump: __ Not installed
Manufacturer's name Dempster
Model number Dynamic HP ____ Volts ____
Length of drop pipe 36 ft. capacity 4 g.p.m.
Type:
__ Submersible __ Turbine
__ Jet X Reciprocating
__ Centrifugal __ Other

18. Elevation:

Topography:
__ Hill
__ Slope
✓ Upland
__ Valley

19. Remarks: customer to pour slab

20. Water well contractor's certification:
This well was drilled under my jurisdiction and this report is true to the best of my knowledge and belief.

Business name Lyman Bros. License No. 110
Address ML
Signed W H Lyman Date 12-16-
Authorized representative

T 34 R 11 (E/W) Sec 20 1/4 1/4 1/4 NW/4 SE

Forward the white, blue and pink copies to the Department of Health and Environment

Form WWC-5

MI-1023