


WATER WELL RECORD

Form WWC-5

Division of Water Resources App. No.

1 LOCATION OF WATER WELL: County: Barber, Fraction: 1/4 NW 1/4 SE 1/4 SE 1/4, Section Number: 32, Township No. T 34 S, Range Number R 12 E X W. Street/Rural Address of Well Location: Approximately 2 miles north of Hardtner.

2 WATER WELL OWNER: Brent Diel, RR#: 212 Coates, City, State, ZIP Code: Kiowa, KS 67070. Global Positioning System (GPS) information: Latitude: 37.037857, Longitude: -98.644222, Elevation: unknown, Datum: NAD 83, Collection Method: WAAS.

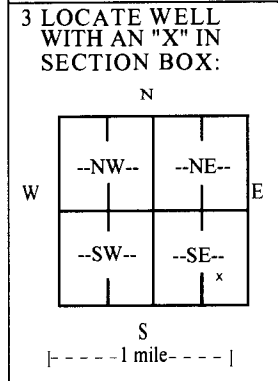

3 LOCATE WELL WITH AN 'X' IN SECTION BOX: 4 DEPTH OF COMPLETED WELL: 100 ft. Depth(s) Groundwater Encountered (1) 24 ft. (2) ft. (3) ft. WELL'S STATIC WATER LEVEL 24 ft. below land surface measured on mo/day/yr 8/18/11. EST. YIELD: Not checked ft. after hours pumping gpm. Bore Hole Diameter 9 in. to 100 ft., and in. to ft. WELL WATER TO BE USED AS: Domestic, Feedlot, Oil field water supply, Dewatering, Injection well, Irrigation, Industrial, Domestic-lawn & garden, Monitoring well.

5 TYPE OF CASING USED: Steel, PVC, Other. CASING JOINTS: Glued, Clamped, Welded, Threaded. Casing diameter 5 in. to 39 ft., Diameter 24 in., Weight 2.36 lbs./ft., Wall thickness or gauge No. 214. TYPE OF SCREEN OR PERFORATION MATERIAL: Steel, Stainless Steel, PVC, Brass, Galvanized Steel, None used (open hole). SCREEN OR PERFORATION MATERIALS ARE: Mill slot, Gauze wrapped, Torch cut, Drilled holes, Louvered shutter, Key punched, Wire wrapped, Saw cut, Other (specify). SCREEN-PERFORATED INTERVALS: From 39 ft. to 99 ft., From ft. to ft. GRAVEL PACK INTERVALS: From 20 ft. to 99 ft., From ft. to ft.

6 GROUT MATERIAL: Neat cement, Cement grout, Bentonite, Other. Grout Intervals: From ft. to ft., From 0 ft. to 20 ft., From ft. to ft. What is the nearest source of possible contamination: Septic tank, Lateral lines, Pit privy, Livestock pens, Insecticide storage, Sewer lines, Cesspool, Sewage lagoon, Fuel storage, Abandoned water well, Watertight sewer lines, Seepage pit, Feedyard, Fertilizer storage, Oil well/gas well, None Known. Direction from well, Distance from well.

Table with columns: FROM, TO, LITHOLOGIC LOG, FROM, TO, LITHO. LOG (cont.) or PLUGGING INTERVALS. Rows show soil layers from 0 to 64 feet depth.

7 CONTRACTOR'S OR LANDOWNER'S CERTIFICATION: This water well was constructed, reconstructed, or plugged under my jurisdiction and was completed on (mo/day/year) 8/18/11 and this record is true to the best of my knowledge and belief. Kansas Water Well Contractor's License No. 185 This Water Well Record was completed on (mo/day/year) 8/30/11 under the business name of Clarke Well & Equipment, Inc. by (signature).

INSTRUCTIONS: Use typewriter or ball point pen. PLEASE PRESS FIRMLY and PRINT clearly. Please fill in blanks and check the correct answers. Send three copies (white, blue, pink) to Kansas Department of Health and Environment, Bureau of Water, Geology Section, 1000 SW Jackson St., Suite 420, Topeka, Kansas 66612-1367. Telephone 785-296-5522. Send one copy to WATER WELL OWNER and retain one for your records. Include fee of \$5.00 for each constructed well. Visit us at http://www.kdheks.gov/waterwell/index.html.