


1 LOCATION OF WATER WELL: Fraction SW 1/4 SW 1/4 SE 1/4 Section Number 4 Township Number T 34 S Range Number R 12 E
 County: Barber
 Distance and direction from nearest town or city street address of well if located within city?
7 N 3/4 E Hardtner

2 WATER WELL OWNER: PAUL GRICE
 RR#, St. Address, Box #: R1 Medicine Lodge KS 67104 Board of Agriculture, Division of Water Resources
 City, State, ZIP Code: Medicine Lodge KS 67104 Application Number:

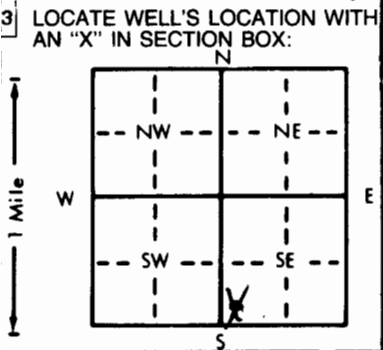

4 DEPTH OF COMPLETED WELL: 52 ft. ELEVATION: ft.
 Depth(s) Groundwater Encountered 15 18 ft. 2. ft. 3. ft.
 WELL'S STATIC WATER LEVEL 15 ft. below land surface measured on mo/day/yr 4-22-82
 Pump test data: Well water was ft. after hours pumping gpm
 Est. Yield 10 gpm; Well water was ft. after hours pumping gpm
 Bore Hole Diameter 9 in. to 52 ft., and in. to ft.
 WELL WATER TO BE USED AS:
 1 Domestic 1 3 Feedlot 1 6 Oil field water supply 1 9 Dewatering 1 12 Other (Specify below)
 2 Irrigation 1 4 Industrial 1 7 Lawn and garden only 1 10 Observation well 1
 Was a chemical/bacteriological sample submitted to Department? Yes No; If yes, mo/day/yr sample was submitted
 Water Well Disinfected? Yes No

5 TYPE OF BLANK CASING USED:
 1 Steel 4 3 RMP (SR) 4 5 Wrought iron 4 8 Concrete tile 4 CASING JOINTS: Glued Clamped
 2 PVC 4 4 ABS 4 6 Asbestos-Cement 4 9 Other (specify below) 4 Welded
 7 Fiberglass 4 Threaded
 Blank casing diameter 4 in. to 20 ft., Dia in. to ft., Dia in. to ft.
 Casing height above land surface 18 in., weight lbs./ft. Wall thickness or gauge No. 173
 TYPE OF SCREEN OR PERFORATION MATERIAL:
 1 Steel 7 3 Stainless steel 7 5 Fiberglass 7 8 RMP (SR) 7 10 Asbestos-cement 7
 2 Brass 7 4 Galvanized steel 7 6 Concrete tile 7 9 ABS 7 11 Other (specify) 7
 12 None used (open hole) 7
 SCREEN OR PERFORATION OPENINGS ARE:
 1 Continuous slot 7 3 Mill slot 7 5 Gauzed wrapped 7 8 Saw cut 7 11 None (open hole) 7
 2 Louvered shutter 7 4 Key punched 7 6 Wire wrapped 7 9 Drilled holes 7
 7 Torch cut 7 10 Other (specify) 7
 SCREEN-PERFORATED INTERVALS: From 20 ft. to 35 ft., From ft. to ft.
 From ft. to ft., From ft. to ft.
 GRAVEL PACK INTERVALS: From 10 ft. to 52 ft., From ft. to ft.
 From ft. to ft., From ft. to ft.

6 GROUT MATERIAL: 1 Neat cement 10 2 Cement grout 10 3 Bentonite 10 4 Other 10
 Grout Intervals: From 0 ft. to 10 ft., From ft. to ft., From ft. to ft.
 What is the nearest source of possible contamination:
 1 Septic tank 1 4 Lateral lines 1 7 Pit privy 1 10 Livestock pens 1 14 Abandoned water well 1
 2 Sewer lines 1 5 Cess pool 1 8 Sewage lagoon 1 11 Fuel storage 1 15 Oil well/Gas well 1
 3 Watertight sewer lines 1 6 Seepage pit 1 9 Feedyard 1 12 Fertilizer storage 1 16 Other (specify below) 1
 13 Insecticide storage 1
 Direction from well? 1200
 How many feet? 1200

FROM	TO	LITHOLOGIC LOG	FROM	TO	LITHOLOGIC LOG
0	10	Soil			
10	18	Stiff Soil			
18	33	Medium Sand			
33	40	Dirty Sand			
40	52	Clay			

7 CONTRACTOR'S OR LANDOWNER'S CERTIFICATION: This water well was (1) constructed, (2) reconstructed, or (3) plugged under my jurisdiction and was completed on (mo/day/year) 4-22-82 and this record is true to the best of my knowledge and belief. Kansas Water Well Contractor's License No. 140 This Water Well Record was completed on (mo/day/yr) 5-1-82 under the business name of Lyman Bros by (signature) Richard Lyman

INSTRUCTIONS: Use typewriter or ball point pen, PLEASE PRESS FIRMLY and PRINT clearly. Please fill in blanks, underline or circle the correct answers. Send top three copies to Kansas Department of Health and Environment, Division of Environment, Environmental Geology Section, Topeka, KS 66620. Send one to WATER WELL OWNER and retain one for your records.

OFFICE USE ONLY T 34 R 12 NW SEC. 4 SW 1/4 SW 1/4 SE 1/4