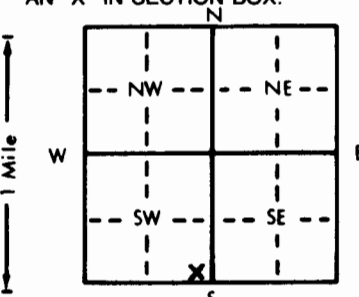


1 LOCATION OF WATER WELL: Fraction SE 1/4 SE 1/4 SW 1/4 Section Number 24 Township Number T 34 S Range Number R 13 EW  
 County South Barber

Distance and direction from nearest town or city street address of well if located within city?  
2 1/2 miles north of Hardtner, 1 west, 1/2 north, 1 west, 1/2 back north

2 WATER WELL OWNER: Bill Lundiff  
 RR#, St. Address, Box # :  
 City, State, ZIP Code : Hardtner Ks.  
 Board of Agriculture, Division of Water Resources  
 Application Number:

3 LOCATE WELL'S LOCATION WITH AN "X" IN SECTION BOX:  
  
 4 DEPTH OF COMPLETED WELL... 118 ft. ELEVATION:  
 Depth(s) Groundwater Encountered 1. 73 ft. 2. ft. 3. ft.  
 WELL'S STATIC WATER LEVEL... 22 ft. below land surface measured on mo/day/yr 6/11/96  
 Pump test data: Well water was ft. after hours pumping gpm  
 Est. Yield 30 gpm; Well water was ft. after hours pumping gpm  
 Bore Hole Diameter... 9 1/2 in. to 118 ft., and in. to ft.  
 WELL WATER TO BE USED AS: 5 Public water supply 8 Air conditioning 11 Injection well  
 1 Domestic 3 Feedlot 6 Oil field water supply 9 Dewatering 12 Other (Specify below)  
 2 Irrigation 4 Industrial 7 Lawn and garden only 10 Monitoring well  
 Was a chemical/bacteriological sample submitted to Department? Yes.....No......; If yes, mo/day/yr sample was submitted  
 Water Well Disinfected?  Yes No

5 TYPE OF BLANK CASING USED:  
 1 Steel 3 RMP (SR) 5 Wrought iron 8 Concrete tile CASING JOINTS: Glued  Clamped  
 2 PVC 4 ABS 6 Asbestos-Cement 9 Other (specify below) Welded  
 7 Fiberglass Threaded  
 Blank casing diameter... 5 in. to 7 ft., Dia in. to ft., Dia in. to ft.  
 Casing height above land surface... 12 in., weight 160 lbs./ft. Wall thickness or gauge No.  
 TYPE OF SCREEN OR PERFORATION MATERIAL:  
 1 Steel 3 Stainless steel 5 Fiberglass  7 PVC 10 Asbestos-cement  
 2 Brass 4 Galvanized steel 6 Concrete tile 9 ABS 11 Other (specify)  
 12 None used (open hole)  
 SCREEN OR PERFORATION OPENINGS ARE:  
 1 Continuous slot 3 Mill slot 5 Gauzed wrapped  8 Saw cut 11 None (open hole)  
 2 Louvered shutter 4 Key punched 6 Wire wrapped 9 Drilled holes  
 7 Torch cut 10 Other (specify)  
 SCREEN-PERFORATED INTERVALS: From 78 ft. to 112 ft., From ft. to ft.  
 From ft. to ft., From ft. to ft.  
 GRAVEL PACK INTERVALS: From 20 ft. to 118 ft., From ft. to ft.  
 From ft. to ft., From ft. to ft.

6 GROUT MATERIAL: 1 Neat cement  2 Cement grout 3 Bentonite 4 Other  
 Grout intervals: From 0 ft. to 20 ft., From ft. to ft., From ft. to ft.  
 What is the nearest source of possible contamination:  
 1 Septic tank 4 Lateral lines 7 Pit privy 10 Livestock pens 14 Abandoned water well  
 2 Sewer lines 5 Cess pool 8 Sewage lagoon 11 Fuel storage 15 Oil well/Gas well  
 3 Watertight sewer lines 6 Seepage pit 9 Feedyard 12 Fertilizer storage 16 Other (specify below)  
 13 Insecticide storage  
 Direction from well? How many feet?

FROM	TO	LITHOLOGIC LOG	FROM	TO	PLUGGING INTERVALS
<u>0</u>	<u>118</u>	<u>Red Clay, loam topsoil</u>			

7 CONTRACTOR'S OR LANDOWNER'S CERTIFICATION: This water well was  (1) constructed (2) reconstructed, or (3) plugged under my jurisdiction and was completed on (mo/day/year) 6/11/96 and this record is true to the best of my knowledge and belief. Kansas Water Well Contractor's License No. 141 This Water Well Record was completed on (mo/day/yr) 6/11/96 under the business name of Lehl & Son Water Well Drilling by (signature) Darryl D. Lehl

OFFICE USE ONLY T R EW SEC 1/4 1/4 1/4