


1 LOCATION OF WATER WELL: Fraction NW 1/4 SW 1/4 NW 1/4 Section Number 27 Township Number T 34 S Range Number R 13 E10  
 County: Darber

Distance and direction from nearest town or city street address of well if located within city?  
4 miles west of Hardtner 3 miles north

2 WATER WELL OWNER: Dan Blunk  
 RR#, St. Address, Box # :  
 City, State, ZIP Code : Hardtner Kans. 67057  
 Board of Agriculture, Division of Water Resources  
 Application Number:

3 LOCATE WELL'S LOCATION WITH AN "X" IN SECTION BOX:

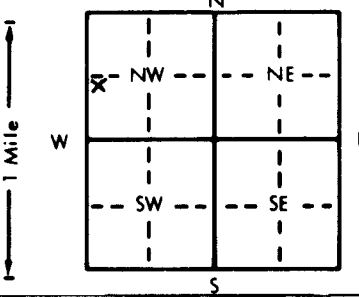

4 DEPTH OF COMPLETED WELL: 60 ft. ELEVATION:  
 Depth(s) Groundwater Encountered 1. 45 ft. 2. ft. 3. ft.  
 WELL'S STATIC WATER LEVEL 15 ft. below land surface measured on mo/day/yr 1-18-91  
 Pump test data: Well water was ft. after hours pumping gpm  
 Est. Yield 12 gpm: Well water was ft. after hours pumping gpm  
 Bore Hole Diameter 8 1/2 in. to 60 ft., and in. to ft.  
 WELL WATER TO BE USED AS:  
 Domestic 3 Feedlot 6 Oil field water supply 9 Dewatering 12 Other (Specify below)  
 2 Irrigation 4 Industrial 7 Lawn and garden only 10 Monitoring well ~~11 Injection well~~  
 Was a chemical/bacteriological sample submitted to Department? Yes.....No X.....; If yes, mo/day/yr sample was submitted  
 Water Well Disinfected? Yes No X

5 TYPE OF CASING USED:  
 1 Steel 3 RMP (SR) 5 Wrought iron 8 Concrete tile CASING JOINTS: Glued X Clamped  
 PVC 4 ABS 7 Fiberglass Other (specify below) Welded  
 Blank casing diameter 5 in. to ft., Dia. in. to ft., Dia. in. to ft.  
 Casing height above land surface 12 in., weight lbs./ft. Wall thickness or gauge No.

TYPE OF SCREEN OR PERFORATION MATERIAL:  
 1 Steel 3 Stainless steel 5 Fiberglass  PVC 10 Asbestos-cement  
 2 Brass 4 Galvanized steel 6 Concrete tile 8 RMP (SR) 11 Other (specify)  
 12 None used (open hole)

SCREEN OR PERFORATION OPENINGS ARE:  
 1 Continuous slot 3 Mill slot 5 Gauzed wrapped  Saw cut 11 None (open hole)  
 2 Louvered shutter 4 Key punched 6 Wire wrapped 9 Drilled holes  
 7 Torch cut 10 Other (specify)

SCREEN-PERFORATED INTERVALS: From 40 ft. to 55 ft., From ft. to ft.  
 From ft. to ft., From ft. to ft.  
 GRAVEL PACK INTERVALS: From 20 ft. to 60 ft., From ft. to ft.  
 From ft. to ft., From ft. to ft.

6 GROUT MATERIAL: 1 Neat cement  Cement grout 3 Bentonite 4 Other  
 Grout Intervals: From 0 ft. to 20 ft., From ft. to ft., From ft. to ft.

What is the nearest source of possible contamination:  
 1 Septic tank 4 Lateral lines 7 Pit privy 10 Livestock pens 14 Abandoned water well  
 2 Sewer lines 5 Cess pool 8 Sewage lagoon 11 Fuel storage 15 Oil well/Gas well  
 3 Watertight sewer lines 6 Seepage pit 9 Feedyard 12 Fertilizer storage 16 Other (specify below)  
 13 Insecticide storage NONE  
 Direction from well? How many feet?

FROM	TO	LITHOLOGIC LOG	FROM	TO	PLUGGING INTERVALS
<u>0</u>	<u>10</u>	<u>Top Soil &amp; Sand</u>			
<u>10</u>	<u>35</u>	<u>Sand &amp; Clay</u>			
<u>35</u>	<u>55</u>	<u>Sand + gravel</u>			
<u>55</u>	<u>60</u>	<u>Red Bed.</u>			

7 CONTRACTOR'S OR LANDOWNER'S CERTIFICATION: This water well was (1) constructed, (2) reconstructed, or (3) plugged under my jurisdiction and was completed on (mo/day/year) 1-18-91 and this record is true to the best of my knowledge and belief. Kansas Water Well Contractor's License No. 141 This Water Well Record was completed on (mo/day/yr) 6-24-91 under the business name of Lehl & Son by (signature) Carl Lehl

OFFICE USE ONLY T R EWM SEC. 1/4 1/4 1/4 1/4