

WATER WELL RECORD


Form WWC-5

Division of Water Resources App. No.

1 LOCATION OF WATER WELL: County: Barber Fraction: 1/4 SW 1/4 SE 1/4 SE 1/4 Section Number: 23 Township No. T 34 S Range Number R 14 E W

Street/Rural Address of Well Location; if unknown, distance & direction from nearest town or intersection: 15 S. Medicine Lodge 2 W Global Positioning System (GPS) information: Latitude: Longitude: Elevation: Datum: Collection Method: Est. Accuracy:

2 WATER WELL OWNER: RR#, Street Address, Box #: Paul Harbaugh 14862 SE Clairmont City, State, ZIP Code: Kiowa, KS 67070

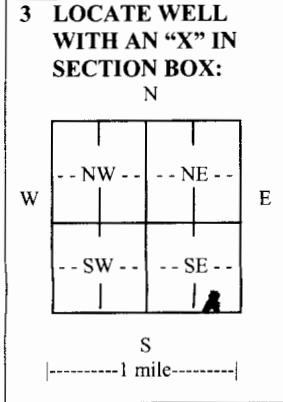

3 LOCATE WELL WITH AN 'X' IN SECTION BOX: 4 DEPTH OF COMPLETED WELL: 32 ft. Depth(s) Groundwater Encountered: 6.6 ft. WELL'S STATIC WATER LEVEL: 6.6 ft. below land surface measured on mo/day/yr: 5-4-12

5 TYPE OF CASING USED: Steel PVC Other CASING JOINTS: Glued Clamped Welded Threaded Casing diameter: 5 in. to 3.2 ft. Diameter: 3.2 in. to 1.60 lbs./ft. TYPE OF SCREEN OR PERFORATION MATERIAL: Steel Stainless Steel PVC Other SCREEN OR PERFORATION OPENINGS ARE: Continuous slot Mill slot Gauze wrapped Torch cut Drilled holes None Louvered shutter Key punched Wire wrapped Saw cut Other SCREEN-PERFORATED INTERVALS: From 24 ft. to 32 ft. GRAVEL PACK INTERVALS: From 23 ft. to 32 ft.

6 GROUT MATERIAL: Neat cement Cement grout Bentonite Other Grout Intervals: From 3 ft. to 23 ft. What is the nearest source of possible contamination: Septic tank Lateral lines Pit privy Livestock pens Insecticide storage Other Sewer lines Cesspool Sewage lagoon Fuel storage Abandoned water well Watertight sewer lines Seepage pit Feedyard Fertilizer storage Oil well/gas well Direction from well: W Distance from well: 1320

Table with columns: FROM, TO, LITHOLOGIC LOG, FROM, TO, LITHO. LOG (cont.) or PLUGGING INTERVALS. Rows contain soil, sand, red clay, and sand w/ clay streaks.

7 CONTRACTOR'S OR LANDOWNER'S CERTIFICATION: This water well was constructed reconstructed, or plugged under my jurisdiction and was completed on (mo/day/yr) 5-4-12 and this record is true to the best of my knowledge and belief. Kansas Water Well Contractor's License No. 140 This Water Well Record was completed on (mo/day/yr) 5-31-12 under the business name of Lyman's Inc by (signature) [Signature]

INSTRUCTIONS: Use typewriter or ball point pen. PLEASE PRESS FIRMLY and PRINT clearly. Please fill in blanks and check the correct answers. Send three copies (white, blue, pink) to Kansas Department of Health and Environment, Bureau of Water, Geology Section, 1000 SW Jackson St., Suite 420, Topeka, Kansas 66612-1367. Telephone 785-296-5524. Send one copy to WATER WELL OWNER and retain one for your records. Include fee of \$5.00 for each constructed well. Visit us at http://www.kdheks.gov/waterwell/index.html.