


1 LOCATION OF WATER WELL: County: Barber Fraction 1/4 SE 1/4 SE 1/4 NE 1/4 Section Number 29 Township Number T 34 S Range Number 15 E W

Street/Rural Address of Well Location; if unknown, distance & direction from nearest town or intersection: If at owner's address, check here 1.75 miles south of
Hetnicks.

Global Positioning Systems (GPS) information:
Latitude: 37.05803 (in decimal degrees)
Longitude: 98.96489 (in decimal degrees)
Elevation: 1605
Datum: WGS84, NAD83, NAD27
Collection Method:
 GPS unit (Make/Model: Garmin ETCX 20)
 Digital Map/Photo, Topographic Map, Land Survey
Est. Accuracy: < 3 m, 3-5 m, 5-15 m, > 15 m

2 WATER WELL OWNER: Phillips 66
RR#, St. Address, Box #: 1708-02 Phillips Building
City, State ZIP Code: Barthesville, OK 74004

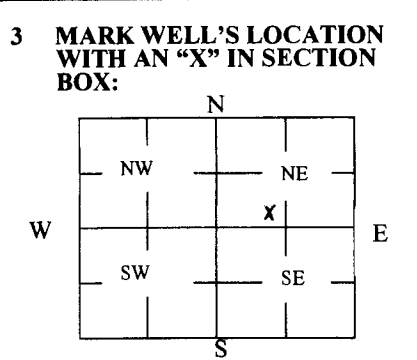

4 DEPTH OF WELL 10.26 ft. bgs
WELL'S STATIC WATER LEVEL 10.22 ft bgs
WELL WAS USED AS:
 Domestic Public Water Supply Dewatering
 Irrigation Oil Field Water Supply Monitoring
 Feedlot Domestic (Lawn & Garden) Injection Well
 Industrial Air Conditioning Other _____
Was a chemical/bacteriological sample submitted to Department? Yes No

5 TYPE OF BLANK CASING USED:
 Steel RMP (SR) Wrought Fiberglass Other (Specify below)
 PVC ABS Asbestos-Cement Concrete Tile
Blank casing diameter 2 in. Was casing pulled? Yes No If yes, how much Cutoff 4' bgs.
Casing height above or below land surface 24 in.

6 GROUT PLUG MATERIAL: Neat cement Cement grout Bentonite Other _____
Grout Plug Intervals: From 0 ft. to 10.26 ft., From _____ ft. to _____ ft., From _____ ft. to _____ ft.
What is the nearest source of possible contamination:
 Septic tank Seepage pit Fuel storage Other (specify below)
 Sewer lines Pit privy Fertilizer storage
 Watertight sewer lines Sewage lagoon Insecticide storage
 Lateral lines Feedyard Abandoned water well Direction from well? _____
 Cess pool Livestock pens Oil well/Gas well How many feet? _____

FROM	TO	PLUGGING MATERIALS	FROM	TO	PLUGGING MATERIALS
<u>0</u>	<u>4</u>	<u>Casing removed, backfilled</u>			
		<u>with native soils.</u>			
<u>4</u>	<u>10.26</u>	<u>Bentonite</u>			

7 CONTRACTOR'S OR LANDOWNER'S CERTIFICATION: This water well was plugged under my jurisdiction and was completed on (mo/day/year) 4/10/15 and this record is true to the best of my knowledge and belief. Kansas Water Well Contractor's License No. 851. This Water Well Record was completed on (mo/day/year) 4/22/15 under the business name of Conestoga - Rovers & Assoc. by (signature) [Signature]

INSTRUCTIONS: Use typewriter or ballpoint pen. Please press firmly and print clearly. Please fill in blanks, underline or circle the correct answers. Send top three copies to Kansas Department of Health and Environment, Bureau of Water, Geology Section, 1000 SW Jackson St., Ste. 420, Topeka, Kansas 66612-1367. Telephone: 785/296-5524. Send one to Water Well Owner and retain one for your records. Visit us at <http://www.kdheks.gov/waterwell/index.html>.