


1 LOCATION OF WATER WELL: County: Comanche Fraction: NW 1/4 SW 1/4 SE 1/4 Section Number: 24 Township Number: 34 S Range Number: 18 E/W

Distance and direction from nearest town or city street address of well if located within city?

5 E Coldwater 135
Barrol Miller

2 WATER WELL OWNER: RR#, St. Address, Box #: 310 E Maple Board of Agriculture, Division of Water Resources
City, State, ZIP Code: Coldwater, KS 67029 Application Number:

3 LOCATE WELL'S LOCATION WITH AN "X" IN SECTION BOX: 4 DEPTH OF COMPLETED WELL: 78 ft. ELEVATION: 41 ft.

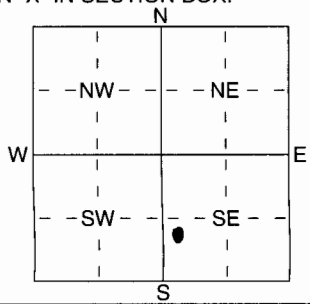

Depth(s) Groundwater Encountered: 1 35 ft. 2 41 ft. 3 8-2-05 ft.
WELL'S STATIC WATER LEVEL: 35 ft. below land surface measured on mo/day/yr
Pump test data: Well water was _____ ft. after _____ hours pumping _____ gpm
Est. Yield: 10 gpm: Well water was _____ ft. after _____ hours pumping _____ gpm
WELL WATER TO BE USED AS: 5 Public water supply 8 Air conditioning 11 Injection well
1 Domestic 3 Feedlot 6 Oil field water supply 9 Dewatering 12 Other (Specify below)
2 Irrigation 4 Industrial 7 Domestic (lawn & garden) 10 Monitoring well

Was a chemical/bacteriological sample submitted to Department? Yes _____ No X; If yes, mo/day/yr sample was submitted Water Well Disinfected: Yes No

5 TYPE OF BLANK CASING USED: 1 Steel 3 RMP (SR) 5 Wrought iron 8 Concrete tile CASING JOINTS: Glued X Clamped _____
2 PVC 4 ABS 7 Fiberglass 9 Other (specify below) Welded _____
Threaded _____

Blank casing diameter: 5 in. to 6.5 ft., Dia _____ in. to _____ ft., Dia _____ in. to _____ ft.
Casing height above land surface: 24 in., weight: 160 lbs./ft. Wall thickness or gauge No. _____

TYPE OF SCREEN OR PERFORATION MATERIAL: 1 Steel 3 Stainless Steel 5 Fiberglass 8 RMP (SR) 10 Asbestos-Cement 11 Other (Specify) _____
2 Brass 4 Galvanized Steel 6 Concrete tile 9 ABS 12 None used (open hole)

SCREEN OR PERFORATION OPENINGS ARE: 1 Continuous slot 3 Mill slot 5 Gauzed wrapped 8 Saw cut 11 None (open hole)
2 Louvered shutter 4 Key punched 6 Wire wrapped 9 Drilled holes
7 Torch cut 10 Other (specify) _____ ft.

SCREEN-PERFORATED INTERVALS: From 65 ft. to 78 ft., From _____ ft. to _____ ft.
From _____ ft. to _____ ft., From _____ ft. to _____ ft.
GRAVEL PACK INTERVALS: From 60 ft. to 78 ft., From _____ ft. to _____ ft.
From _____ ft. to _____ ft., From _____ ft. to _____ ft.

6 GROUT MATERIAL: 1 Neat cement 2 Cement grout 3 Bentonite 4 Other _____
Grout Intervals: From 0 ft. to 60 ft., From _____ ft. to _____ ft., From _____ ft. to _____ ft.

What is the nearest source of possible contamination: 1 Septic tank 4 Lateral lines 7 Pit privy 10 Livestock pens 14 Abandoned water well
2 Sewer lines 5 Cess pool 8 Sewage lagoon 11 Fuel storage 15 Oil well/Gas well
3 Watertight sewer lines 6 Seepage pit 9 Feedyard 12 Fertilizer storage 16 Other (specify below)
13 Insecticide storage

Direction from well? SE How many feet? 500

FROM	TO	LITHOLOGIC LOG	FROM	TO	PLUGGING INTERVALS
<u>0</u>	<u>3</u>	<u>Soil</u>			
<u>3</u>	<u>5</u>	<u>fine sand</u>			
<u>5</u>	<u>12</u>	<u>clean sand</u>			
<u>12</u>	<u>78</u>	<u>Red phyll. w/ breaks</u>			
		<u>Lost Circulation</u>			

7 CONTRACTOR'S OR LANDOWNER'S CERTIFICATION: This water well was (1) constructed, (2) reconstructed, or (3) plugged under my jurisdiction and was completed on (mo/day/year) 8-2-05 and this record is true to the best of my knowledge and belief. Kansas Water Well Contractor's Licence No. 140 This Water Well Record was completed on (mo/day/yr) 8-31-05 under the business name of Lyman's Inc by (signature) [Signature]