


1 LOCATION OF WATER WELL: County: COMANCHE Fraction: NW 1/4 NW 1/4 SW 1/4 Section Number: 31 Township Number: T 34 S Range Number: R 18 E/W

Distance and direction from nearest town or city street address of well if located within city?
From Coldwater, KS 15 1/2 South

2 WATER WELL OWNER: OLLER FARMS
 RR#, St. Address, Box #: Coldwater, KS
 City, State, ZIP Code: Coldwater, KS
 Board of Agriculture, Division of Water Resources
 Application Number:

3 LOCATE WELL'S LOCATION WITH AN "X" IN SECTION BOX:

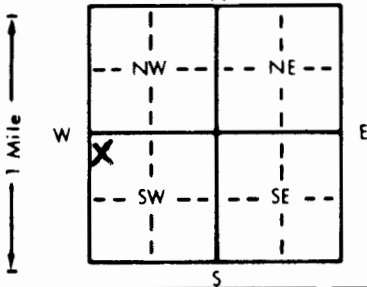

4 DEPTH OF COMPLETED WELL: 94 ft. ELEVATION:
 Depth(s) Groundwater Encountered: 1. 75 ft. 2. ft. 3. ft.
 WELL'S STATIC WATER LEVEL: 55 ft. below land surface measured on mo/day/yr

Pump test data: Well water was _____ ft. after _____ hours pumping _____ gpm
 Est. Yield _____ gpm Well water was _____ ft. after _____ hours pumping _____ gpm

Bore Hole Diameter: 10 in. to 94 ft. and _____ in. to _____ ft.

WELL WATER TO BE USED AS:
 5 Public water supply 8 Air conditioning 11 Injection well
1 Domestic 3 Feedlot 6 Oil field water supply 9 Dewatering 12 Other (Specify below)
 2 Irrigation 4 Industrial 7 Lawn and garden only 10 Monitoring well

Was a chemical/bacteriological sample submitted to Department? Yes _____ No If yes, mo/day/yr sample was submitted
 Water Well Disinfected? Yes No

5 TYPE OF BLANK CASING USED:
 1 Steel 3 RMP (SR) 5 Wrought iron 8 Concrete tile CASING JOINTS: Glued Clamped _____
2 PVC 4 ABS 6 Asbestos-Cement 9 Other (specify below) Welded _____
 7 Fiberglass Threaded _____

Blank casing diameter: 5 in. to 75 ft. Dia _____ in. to _____ ft. Dia _____ in. to _____ ft.
 Casing height above land surface: 24 in. weight 2.37 lbs./ft. Wall thickness or gauge No. 214

TYPE OF SCREEN OR PERFORATION MATERIAL:
 1 Steel 3 Stainless steel 5 Fiberglass 8 RMP (SR) 10 Asbestos-cement 11 Other (specify) _____
 2 Brass 4 Galvanized steel 6 Concrete tile 9 ABS 12 None used (open hole)

SCREEN OR PERFORATION OPENINGS ARE:
 1 Continuous slot 3 Mill slot 5 Gauzed wrapped 8 Saw cut 11 None (open hole)
 2 Louvered shutter 4 Key punched 6 Wire wrapped 9 Drilled holes
 7 Torch cut 10 Other (specify) _____

SCREEN-PERFORATED INTERVALS: From 75 ft. to 94 ft. From _____ ft. to _____ ft.
 From _____ ft. to _____ ft. From _____ ft. to _____ ft.
 GRAVEL PACK INTERVALS: From 20 ft. to 94 ft. From _____ ft. to _____ ft.
 From _____ ft. to _____ ft. From _____ ft. to _____ ft.

6 GROUT MATERIAL: 1 Neat cement 2 Cement grout 3 Bentonite 4 Other _____
 Grout Intervals: From 0 ft. to 20 ft. From _____ ft. to _____ ft. From _____ ft. to _____ ft.

What is the nearest source of possible contamination:
 1 Septic tank 4 Lateral lines 7 Pit privy 10 Livestock pens 14 Abandoned water well
 2 Sewer lines 5 Cess pool 8 Sewage lagoon 11 Fuel storage 15 Oil well/Gas well
 3 Watertight sewer lines 6 Seepage pit 9 Feedyard 12 Fertilizer storage 16 Other (specify below)
 13 Insecticide storage NONE

Direction from well? _____ How many feet? _____

FROM	TO	LITHOLOGIC LOG	FROM	TO	PLUGGING INTERVALS
0	15	DARK Top Soil			
16	30	DARK CLAY			
31	40	CLAY & SAND			
41	74	RED CLAY			
75	85	SHALE LOOSE			
86	94	RED ROCK			

7 CONTRACTOR'S OR LANDOWNER'S CERTIFICATION: This water well was (1) constructed, (2) reconstructed, or (3) plugged under my jurisdiction and was completed on (mo/day/year) 3-14-95 and this record is true to the best of my knowledge and belief. Kansas Water Well Contractor's License No. 411 This Water Well Record was completed on (mo/day/yr) 3-22-95 under the business name of LEH'S WATER WELL by (signature) Ron Lehl

OFFICE USE ONLY
T
R
E/W
SEC.
1/4
1/4
1/4