

MW # 3

1 LOCATION OF WATER WELL: County: <u>Sumner Co.</u>	Fraction: <u>NW 1/4 NW 1/4 SE 1/4</u>	Section Number: <u>4</u>	Township Number: <u>T 34 S</u>	Range Number: <u>R 2 EW</u>
--	---------------------------------------	--------------------------	--------------------------------	-----------------------------

Distance and direction from nearest town or city street address of well if located within city?

CORBIN KS. CITY LIMITS2 WATER WELL OWNER: Walcott Lincoln & GARVEY ELEVATOR

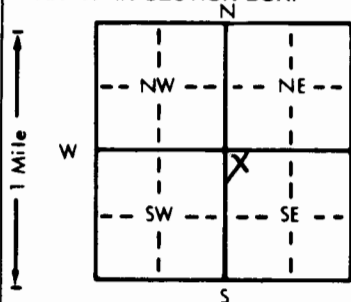
RR#, St. Address, Box #:

City, State, ZIP Code: CORBIN, KS.

Board of Agriculture, Division of Water Resources

Application Number:

3 LOCATE WELL'S LOCATION WITH AN "X" IN SECTION BOX:

4 DEPTH OF COMPLETED WELL: 25 ft. ELEVATION:

Depth(s) Groundwater Encountered 1. ft. 2. ft. 3. ft.

WELL'S STATIC WATER LEVEL ft. below land surface measured on mo/day/yr

Pump test data: Well water was ft. after hours pumping gpm

Est. Yield gpm: Well water was ft. after hours pumping gpm

Bore Hole Diameter: 7 1/4 in. to 25 ft., and in. to ft.

WELL WATER TO BE USED AS:

1 Domestic 3 Feedlot 6 Oil field water supply 9 Dewatering 12 Other (Specify below)

2 Irrigation 4 Industrial 7 Lawn and garden only ☒ Monitoring well

Was a chemical/bacteriological sample submitted to Department? Yes No If yes, mo/day/yr sample was submitted

Water Well Disinfected? Yes No

5 TYPE OF BLANK CASING USED:

1 Steel 3 RMP (SR)

☒ PVC 4 ABS

5 Wrought iron

6 Asbestos-Cement

7 Fiberglass

8 Concrete tile

9 Other (specify below)

CASING JOINTS: Glued Clamped

Welded

Threaded ☒Blank casing diameter 2 in. to 15 ft., Dia. in. to ft., Dia. in. to ft.Casing height above land surface 0 in., weight Sched 40 lbs./ft. Wall thickness or gauge No.

TYPE OF SCREEN OR PERFORATION MATERIAL:

1 Steel 3 Stainless steel

2 Brass 4 Galvanized steel

5 Fiberglass

6 Concrete tile

☒ PVC

8 RMP (SR)

9 ABS

10 Asbestos-cement

11 Other (specify)

12 None used (open hole)

SCREEN OR PERFORATION OPENINGS ARE:

1 Continuous slot ☒ Mill slot 0.10

2 Louvered shutter 4 Key punched

5 Gauzed wrapped

6 Wire wrapped

7 Torch cut

8 Saw cut

9 Drilled holes

10 Other (specify)

11 None (open hole)

SCREEN-PERFORATED INTERVALS: From 25 ft. to 15 ft., From ft. to ft.

From ft. to ft., From ft. to ft.

GRAVEL PACK INTERVALS: From 25 ft. to 13 ft., From ft. to ft.

From ft. to ft., From ft. to ft.

6 GROUT MATERIAL:

1 Neat cement

2 Cement grout

☒ Bentonite

4 Other

Grout Intervals: From 11 ft. to 3 ft., From 13 ft. to 11 ft., From ft. to ft.

What is the nearest source of possible contamination:

1 Septic tank

4 Lateral lines

7 Pit privy

10 Livestock pens

14 Abandoned water well

2 Sewer lines

5 Cess pool

8 Sewage lagoon

11 Fuel storage

15 Oil well/Gas well

☒ Watertight sewer lines

6 Seepage pit

9 Feedyard

12 Fertilizer storage

16 Other (specify below)

13 Insecticide storage

Direction from well? South EastHow many feet? 60'

FROM	TO	LITHOLOGIC LOG	FROM	TO	PLUGGING INTERVALS
0	1	SILT, dk reddish gray, hard			
1	3	Clayey silt, dk, damp			
3	4	Clayey silt, reddish brn.			
4	5	as above + damp			
5	7	Clayey sand, yellowish red			
7	8	Sandy silt, yellowish red, damp			
8	9.5	Silt, yellowish red, damp			
9.5	14	Silty sand, yellow, medium dense			
14	18	Silty sand, reddish yellow moist			
18	25	Silty sand, SATURATED			

7 CONTRACTOR'S OR LANDOWNER'S CERTIFICATION: This water well was (1) constructed, (2) reconstructed, or (3) plugged under my jurisdiction and was completed on (mo/day/year) 10-16-94 and this record is true to the best of my knowledge and belief. KansasWater Well Contractor's License No. 575This Water Well Record was completed on (mo/day/year) 10-18-94under the business name of KURTZ Environmental Serviceby (signature) [Signature]