


1 LOCATION OF WATER WELL: County: <u>Sumner</u>	Fraction: <u>NE 1/4 NW 1/4 NW 1/4</u>	Section Number: <u>4</u>	Township Number: <u>34 S</u>	Range Number: <u>2 EW</u>
--	---------------------------------------	--------------------------	------------------------------	---------------------------

Distance and direction from nearest town or city street address of well if located within city?

1107 S. Robin Rd Corbin, KS

2 WATER WELL OWNER: RR#, St. Address, Box # : City, State, ZIP Code	<u>Brent Rice</u> <u>463 W. 9th St</u> <u>Wellington, KS 67152</u>	Board of Agriculture, Division of Water Resources Application Number: <u>MW9</u>
---	--	---

3 LOCATE WELL'S LOCATION WITH AN "X" IN SECTION BOX:	4 DEPTH OF COMPLETED WELL: <u>25.5</u> ft. ELEVATION:
--	---

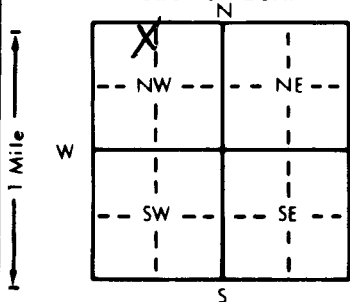

Depth(s) Groundwater Encountered	1	ft.	2	ft.	3	ft.
WELL'S STATIC WATER LEVEL	<u>19.6</u>	ft. below land surface measured on	mo/day/yr			
Pump test data: Well water was		ft. after	hours pumping	gpm		
Est. Yield		gpm: Well water was	ft. after	hours pumping	gpm	
Bore Hole Diameter		in. to	ft. and	in. to	ft.	
WELL WATER TO BE USED AS:	5 Public water supply	8 Air conditioning	11 Injection well			
1 Domestic	3 Feedlot	6 Oil field water supply	9 Dewatering	12 Other (Specify below)		
2 Irrigation	4 Industrial	7 Lawn and garden only	10 Monitoring well			
Was a chemical/bacteriological sample submitted to Department? Yes	No	X				
If yes, mo/day/yr sample was submitted						
Water Well Disinfected? Yes	No	X				

5 TYPE OF BLANK CASING USED:	5 Wrought iron	8 Concrete tile	CASING JOINTS: Glued	Clamped
1 Steel	3 RMP (SR)	6 Asbestos-Cement	9 Other (specify below)	Welded
2 PVC	4 ABS	7 Fiberglass		Threaded
Blank casing diameter	<u>2</u> in. to <u>15.5</u> ft. Dia			
Casing height above land surface	<u>0</u> in. weight <u>716</u> lbs./ft.			
Wall thickness or gauge No.	<u>154</u>			

TYPE OF SCREEN OR PERFORATION MATERIAL:	7 PVC	10 Asbestos-cement		
1 Steel	3 Stainless steel	5 Fiberglass	8 RMP (SR)	11 Other (specify)
2 Brass	4 Galvanized steel	6 Concrete tile	9 ABS	12 None used (open hole)

SCREEN OR PERFORATION OPENINGS ARE:	5 Gauzed wrapped	8 Saw cut	11 None (open hole)
1 Continuous slot	3 Mill slot	6 Wire wrapped	9 Drilled holes
2 Louvered shutter	4 Key punched	7 Torch cut	10 Other (specify)

SCREEN-PERFORATED INTERVALS:	From <u>15.5</u> ft. to <u>25.5</u> ft.	From	ft. to	ft.
GRAVEL PACK INTERVALS:	From <u>13.5</u> ft. to <u>25.5</u> ft.	From	ft. to	ft.

6 GROUT MATERIAL:	1 Neat cement	2 Cement grout	3 Bentonite	4 Other
Grout Intervals:	From <u>0</u> ft. to <u>3</u> ft.	From <u>3</u> ft. to <u>13.5</u> ft.	From	ft. to
What is the nearest source of possible contamination:	10 Livestock pens	14 Abandoned water well		
1 Septic tank	4 Lateral lines	7 Pit privy	11 Fuel storage	15 Oil well/Gas well
2 Sewer lines	5 Cess pool	8 Sewage lagoon	12 Fertilizer storage	16 Other (specify below)
3 Watertight sewer lines	6 Seepage pit	9 Feedyard	13 Insecticide storage	

Removed Fuel Storage

Direction from well?	How many feet?
----------------------	----------------

FROM	TO	LITHOLOGIC LOG	FROM	TO	PLUGGING INTERVALS
<u>0</u>	<u>4</u>	<u>Fill Sand</u>			
<u>4</u>	<u>8.5</u>	<u>Silty Clay</u>			
<u>8.5</u>	<u>19.0</u>	<u>Clayey Silty</u>			
<u>19.0</u>	<u>25.5</u>	<u>Sand</u>			

7 CONTRACTOR'S OR LANDOWNER'S CERTIFICATION: This water well was (1) <u>constructed</u> , (2) reconstructed, or (3) plugged under my jurisdiction and was completed on (mo/day/year) <u>8-8-96</u> and this record is true to the best of my knowledge and belief. Kansas Water Well Contractor's License No. <u>554</u> This Water Well Record was completed on (mo/day/yr) <u>8-29-96</u> under the business name of <u>Wooster Pump &amp; Well, Inc</u> by (signature) <u>Jeff G. Wooster</u>
--