


WATER WELL RECORD Form WWC-5 KSA 82a-1212

Distance and direction from nearest town or city street address of well if located within city?
1107 S. Robin Rd, Corbin, KS

3 LOCATE WELL'S LOCATION WITH AN "X" IN SECTION BOX: 4 DEPTH OF COMPLETED WELL: 25.5 ft. ELEVATION: _____

Depth(s) Groundwater Encountered 1. _____ ft. 2. _____ ft. 3. _____ ft.

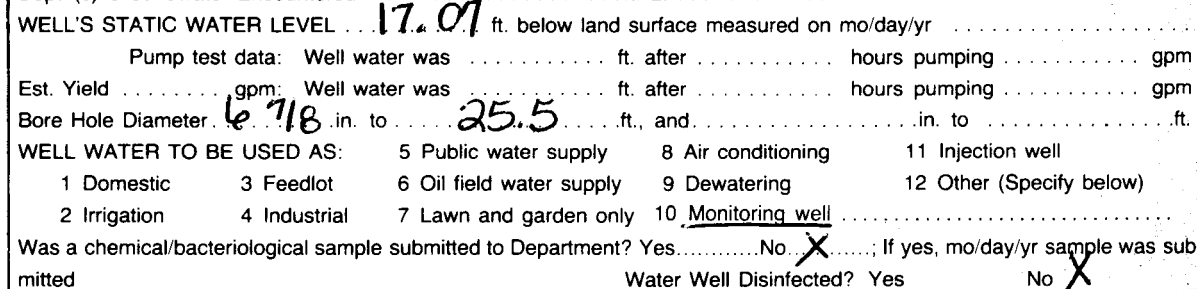

Blank casing diameter . . . 2 in. to 15.5 ft. Dia . . . in. to . . . ft. Dia . . . in. to . . . ft.
Casing height above land surface . . . 0 in. weight . . . 716 lbs./ft. Wall thickness or gauge No. . . 154

SCREEN OR PERFORATION OPENINGS ARE:

1 Continuous slot	3 Mill slot	5 Gauzed wrapped	8 Saw cut	11 None (open hole)
2 Louvered shutter	4 Key punched	6 Wire wrapped	9 Drilled holes	
		7 Torch cut	10 Other (specify)	

6 GROUT MATERIAL: 1 Neat cement 2 Cement grout 3 Bentonite 4 Other
Grout Intervals: From 0 ft to 3 ft From 3 ft to 13.5 ft From 13.5 ft to 15 ft

Direction from well?			How many feet?		
FROM	TO	LITHOLOGIC LOG	FROM	TO	PILLGING INTERVALS

7 CONTRACTOR'S OR LANDOWNER'S CERTIFICATION: This water well was (1) constructed, (2) reconstructed, or (3) plugged under my jurisdiction and was completed on (mo/day/year) 8-8-96 and this record is true to the best of my knowledge and belief. Kansas Water Well Contractor's License No. 554 This Water Well Record was completed on (mo/day/yr) 8-29-96 under the business name of Woolf & Pumps Well Serv by (signature) [Signature]

INSTRUCTIONS: Use typewriter or ball point pen, PLEASE PRESS FIRMLY and PRINT clearly. Please fill in blanks, underline or circle the correct answers. Send top three copies to Kansas Department of Health and Environment, Bureau of Water, Topeka, Kansas 66620-0001. Telephone: 913-296-5545. Send one to WATER WELL OWNER and retain one for your records.