


AS-1

1 LOCATION OF WATER WELL: County: Sumner Fraction: NW 1/4 NW 1/4 NW 1/4 Section, Number: 4 Township Number: T 34 S Range Number: R 2 EW

Distance and direction from nearest town or city street address of well if located within city?
1107 S. Robin Rd, Corbin, Ks

2 WATER WELL OWNER: KDHE - Forbes Field, Bld 740 Board of Agriculture, Division of Water Resources
 RR#, St. Address, Box #: Topeka, KS 66620-0001 Application Number:

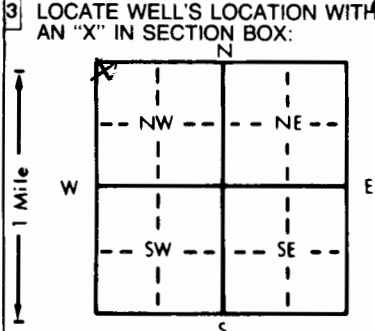

4 DEPTH OF COMPLETED WELL: 28.5 ft. ELEVATION: _____

Depth(s) Groundwater Encountered 1. 17.55 ft. 2. 21.8 ft. 3. _____ ft.

WELL'S STATIC WATER LEVEL 17.55 ft. below land surface measured on mo/day/yr 08/04/98

Pump test data: Well water was _____ ft. after _____ hours pumping _____ gpm

Est. Yield _____ gpm: Well water was _____ ft. after _____ hours pumping _____ gpm

Bore Hole Diameter: 8.625 in. to 28.5 ft., and _____ in. to _____ ft.

WELL WATER TO BE USED AS:

5 Public water supply	8 Air conditioning	11 Injection well
1 Domestic	3 Feedlot	6 Oil field water supply
2 Irrigation	4 Industrial	7 Lawn and garden only
		10 Monitoring well

Other (Specify below): Air s. purge

Was a chemical/bacteriological sample submitted to Department? Yes _____ No X If yes, mo/day/yr sample was submitted _____

Water Well Disinfected? Yes _____ No X

5 TYPE OF BLANK CASING USED:

1 Steel	3 RMP (SR)	6 Asbestos-Cement	9 Other (specify below)
<u>2 PVC</u>	4 ABS	7 Fiberglass	

CASING JOINTS: Glued _____ Clamped _____
 Welded _____ Threaded X

Blank casing diameter 2 in. to 26 ft., Dia _____ in. to _____ ft., Dia _____ in. to _____ ft.

Casing height above land surface FLUSH in., weight SC140 lbs./ft. Wall thickness or gauge No. _____

TYPE OF SCREEN OR PERFORATION MATERIAL:

1 Steel	3 Stainless steel	5 Fiberglass	8 RMP (SR)	11 Other (specify)
2 Brass	4 Galvanized steel	6 Concrete tile	9 ABS	12 None used (open hole)

SCREEN OR PERFORATION OPENINGS ARE:

1 Continuous slot	<u>3 Mill slot</u>	5 Gauzed wrapped	8 Saw cut	11 None (open hole)
2 Louvered shutter	4 Key punched	6 Wire wrapped	9 Drilled holes	
		7 Torch cut	10 Other (specify)	

SCREEN-PERFORATED INTERVALS: From 26 ft. to 28.5 ft., From _____ ft. to _____ ft.

GRAVEL PACK INTERVALS: From 17 ft. to 28.5 ft., From _____ ft. to _____ ft.

6 GROUT MATERIAL: 1 Neat cement 2 Cement grout 3 Bentonite 4 Other

Grout Intervals: 3 From 15 ft. to 17 ft. 2 From 0 ft. to 15 ft. From _____ ft. to _____ ft.

What is the nearest source of possible contamination:

1 Septic tank	4 Lateral lines	7 Pit privy	10 Livestock pens	14 Abandoned water well
2 Sewer lines	5 Cess pool	8 Sewage lagoon	11 Fuel storage	15 Oil well/Gas well
3 Watertight sewer lines	6 Seepage pit	9 Feedyard	12 Fertilizer storage	<u>16 Other (specify below)</u>

Direction from well? _____ How many feet? _____

FROM	TO	LITHOLOGIC LOG	FROM	TO	PLUGGING INTERVALS
0	18	clay sand end of borehole			
18	28.5				
28.5	TD				

7 CONTRACTOR'S OR LANDOWNER'S CERTIFICATION: This water well was reconstructed (1) constructed, (2) reconstructed, or (3) plugged under my jurisdiction and was completed on (mo/day/year) 8/14/98 and this record is true to the best of my knowledge and belief. Kansas Water Well Contractor's License No. 585 This Water Well Record was completed on (mo/day/yr) 8/10/98 under the business name of Azi by (signature) Adrian G. Deuser