

1 LOCATION OF WATER WELL:	Fraction SE ¼ NW ¼ NW ¼	Section Number 4	Township Number T 34 S	Range Number R 2 E/W
---------------------------	--------------------------------	-------------------------	-------------------------------	-----------------------------

Distance and direction from nearest town or city street address of well if located within city?

2 WATER WELL OWNER: **Corbin Service**RR#, St. Address, Box # : **1107 S Robin Road**

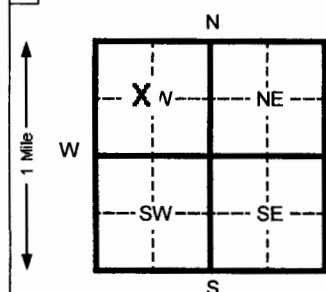
Board of Agriculture, Division of Water Resources

City, State, ZIP Code : **Corbin, KS 67022**

Application Number:

3 LOCATE WELL'S LOCATION WITH AN "X" IN SECTION BOX:

4 DEPTH OF COMPLETED WELL

25 ft. ELEVATION:

Depth(s) Groundwater Encountered 1 _____ ft. 2 _____ ft. 3 _____ ft.

WELL'S STATIC WATER LEVEL **17.06** ft. below land surface measured on mo/day/yr

Pump test data: Well water was _____ ft. after _____ hours pumping _____ gpm

Est. Yield _____ gpm: Well water was _____ ft. after _____ hours pumping _____ gpm

Bore Hole Diameter **8** in. to **25** ft. and _____ in. to _____ ft.

WELL WATER TO BE USED AS: 5 Public water supply 8 Air conditioning 11 Injection well

1 Domestic 3 Feed lot 6 Oil field water supply 9 Dewatering 12 Other (Specify below)

2 Irrigation 4 Industrial 7 Lawn and garden (domestic) 10 Monitoring well

Was a chemical/bacteriological sample submitted to Department? Yes _____ No **X** If yes, mo/day/yr sample wassubmitted Water Well Disinfected? Yes _____ No **X**

5 TYPE OF BLANK CASING USED:

5 Wrought Iron

8 Concrete tile

CASING JOINTS: Glued _____ Clamped _____

1 Steel

3 RMP (SR)

6 Asbestos-Cement

9 Other (specify below)

Welded _____

2 PVC

4 ABS

7 Fiberglass

Threaded _____

Blank casing diameter **2** in. to **10** ft. Dia _____ in. to _____ ft. Dia _____ in. to _____ ft.Casing height above land surface **-0.28** in., weight **.0716** lbs./ft. Wall thickness or gauge No. **1.54**

TYPE OF SCREEN OR PERFORATION MATERIAL:

1 Steel

3 Stainless steel

5 Fiberglass

7 PVC

10 Asbestos-cement

2 Brass

4 Galvanized steel

6 Concrete tile

8 RMP (SR)

11 Other (specify)

9 ABS

12 None used (open hole)

SCREEN OR PERFORATION OPENINGS ARE:

1 Continuous slot

3 Mill slot

5 Gauzed wrapped

8 Saw cut

11 None (open hole)

2 Louvered shutter

4 Key punched

6 Wire wrapped

9 Drilled holes

7 Torch cut

10 Other (specify)

SCREEN-PERFORATED INTERVALS: From **10** ft. to **25** ft. From _____ ft. to _____ ft.

From _____ ft. to _____ ft. From _____ ft. to _____ ft.

GRAVEL PACK INTERVALS: From **8** ft. to **25** ft. From _____ ft. to _____ ft.

From _____ ft. to _____ ft. From _____ ft. to _____ ft.

6 GROUT MATERIAL:

1 Neat cement

2 Cement grout

3 Bentonite

4 Other _____

Grout Intervals From **1** ft. to **8** ft. From _____ ft. to _____ ft. From _____ ft. to _____ ft.

What is the nearest source of possible contamination:

1 Septic tank

4 Lateral lines

7 Pit privy

10 Livestock pens

14 Abandoned water well

2 Sewer lines

5 Cess pool

8 Sewage lagoon

11 Fuel storage

15 Oil well/ Gas well

3 Watertight sewer lines

6 Seepage pit

9 Feedyard

12 Fertilizer storage

16 Other (specify below)

13 Insecticide storage

Contaminated Site

Direction from well?

How many feet?

FROM	TO	CODE	LITHOLOGIC LOG	FROM	TO	PLUGGING INTERVALS
0	2		Brown silty soil, dry			
2	5.5		Reddish brown dense sandy Clay, dry to slightly moist, some caliche			
5.5	6.5		Red dry silt			
6.5	12		Reddish orange silty clay moist plastic			
12	24.5		Grades to fine to medium Grained clayey silty sand, Slightly moist, poorly sorted red			
24.5	25		Red dense clay			

7 CONTRACTOR'S OR LANDOWNER'S CERTIFICATION: This water well was (1) constructed, (2) reconstructed, or (3) plugged under my jurisdiction and was completed on (mo/day/yr) **2/16/06** and this record is true to the best of my knowledge and belief. KansasWater Well Contractor's License No. **554**This Water Well Record was completed on (mo/day/yr) **3/24/06**

under the business name of

Woofert Pump & Well, Inc

by (signature)

INSTRUCTIONS: Please fill in blanks and circle the correct answers. Send three copies to Kansas Department of Health and Environment, Bureau of Water, 1000 S W Jackson St., Ste. 420, Topeka, Kansas 66612-1367. Telephone: 913-296-5545. Send one to WATER WELL OWNER and retain one for your records.