USE TYPEWRITER OR BALL POINT PEN-PRESS FIRMLY, PRINT CLEARLY.

WATER WELL RECORD
KSA 82a-1201-1215

Kansas Department of Health and Environment-Division of Environment
(Water well Contractors)
Topeka, Kansas 66620

1. Location of well:	County	Fraction	Section number	Township number	Range number
	Comanche	CN1/4 SW 1/4 NE 1/4	33	T 34 S	R 20 (W)

2. Distance and direction from nearest town or city: not available

Street address of well location if in city:

3. Owner of well: Slawson Drilling Co.

R.R. or street:

City, state, zip code: Wichita, Ks.

X. Locate with "X" in section below:

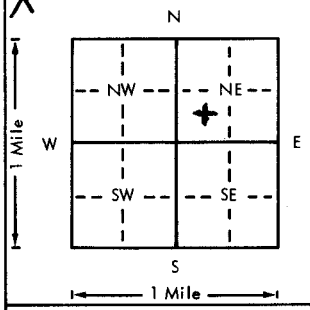

Sketch map:

6. Bore hole dia. 7 7/8 in. Completion date 9-11-78
Well depth 76 ft.

7. __ Cable tool X Rotary __ Driven __ Dug
__ Hollow rod __ Jetted __ Bored __ Reverse rotary

8. Use: __ Domestic __ Public supply __ Industry
__ Irrigation __ Air conditioning __ Stock
__ Lawn X Oil field water __ Other

9. Casing: Material PVC X
Threaded ___ Welded ___
RMP ___ PVC ___
Dia. 5 in. to 76 ft. depth
Dia. ___ in. to ___ ft. depth
Height: Above or ~~below~~ XXX Surface 12 in.
Weight 2.8 lbs./ft.
Wall Thickness: inches or X gage No. .265

10. Screen: Manufacturer's name
Type PVC Dia. 5"
Slot/gauze .20 fine Length 30'
Set between 36 ft. and 76 ft.
___ ft. and ___ ft.
Gravel pack? X Size range of material #1 Fine

11. Static water level: 11 ft. below land surface Date 09/11/78 (mo./day/yr.)

12. Pumping level below land surfaces:
___ ft. after ___ hrs. pumping ___ g.p.m.
___ ft. after ___ hrs. pumping ___ g.p.m.
Estimated maximum yield 100+ g.p.m.

13. Water sample submitted: mo./day/yr.
__ Yes X No Date

14. Well head completion:
__ Pitless adapter 24 Inches above grade

15. Well grouted? Yes
With: X Neat cement ___ Bentonite ___ Concrete
Depth: From 0 ft. to 3 ft.

X. Nearest source of possible contamination: None
ft. ___ Direction ___ Type
Well disinfected upon completion? X Yes ___ No

17. Pump: ___ Not installed
Manufacturer's name Customer Installed
Model number Pump HP ___ Volts ___
Length of drop pipe ___ ft. capacity ___ g.p.m.
Type:
__ Submersible __ Turbine
__ Jet __ Reciprocating
__ Centrifugal __ Other

5. Type and color of material	From	To
Fine Sand	0	8
Med. to Lar. Sand Gravel Some Clay streaks	8	80

(Use a second sheet if needed)

18. Elevation:

Topography:
__ Hill
__ Slope
__ Upland
X Valley

19. Remarks:
Did the best we could
caved-in

20. Water well contractor's certification:
This well was drilled under my jurisdiction and this report is true to the best of my knowledge and belief.
Friesen Windmill 252
Business name License No.
Address Meade, Kansas 67864
Signed [signature] Date 11-21-78
Authorized representative

T 34 S R 20 (W) Sec 33 1/4 1/4 1/4 1/4 CN SW NE

Forward the white, blue and pink copies to the Department of Health and Environment

Form WWC-5

MI-1023