


1 LOCATION OF WATER WELL: Fraction Section Number Township Number Range Number
 COUNTY: CLARK NE 1/4 SE 1/4 NW 1/4 6 T 34 S R 21 W

Distance and direction from nearest town or city street address of well if located within city?
 5 MILES SOUTH OF SITKA

2 WATER WELL OWNER: BELL, MERLYN Board of Agriculture, Division of Water Resources
 RR#, St. Address, Box #: 2621 2ND AV #1701 Application Number:
 City, State, ZIP code: SEATTLE, WA 98121-

3 LOCATE WELL'S LOCATION WITH AN "X" IN SECTION BOX:

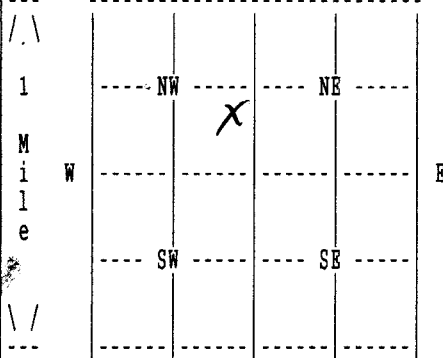

4 DEPTH OF COMPLETED WELL 50 ELEVATION: 0
 Depth(s) Groundwater Encountered 1. 0 ft. 2. 0 ft. 3. 0 ft.

WELL'S STATIC WATER LEVEL 27 ft. below land surface measured on mo/day/yr 11/09/04
 Pump test data: Well water was 0 ft. after 0 hours pumping 0 gpm

Estimated Yield 0 gpm: Well water was 0 ft. after 0 hours pumping 0 gpm

Bore Hole Diameter 8.75 in. to 50 ft., and in. to 0 ft.

WELL WATER TO BE USED AS: LIVESTOCK

Was a chemical/bacteriological sample submitted to department? No ;
 If yes, mo/day/yr sample was submitted Water well disinfected? Yes

5 TYPE OF BLANK CASING USED: PVC CASING JOINTS: GLUED
 Blank casing diameter 5 in. to 30 ft., Dia in. to 0 ft., Dia in. to 0 ft.
 Casing height above land surface 12 in., weight 0 lbs/ft. Wall thickness or gauge No. 26
 TYPE OF SCREEN OR PERFORATION MATERIAL: PVC
 SCREEN OR PERFORATION OPENINGS ARE: SAW CUT

SCREEN PERFORATED INTERVALS: From 30 ft. to 50 ft., From 0 ft. to 0 ft.
 From 0 ft. to 0 ft., From 0 ft. to 0 ft.
 GRAVEL PACK INTERVALS: From 22 ft. to 50 ft., From 0 ft. to 0 ft.
 From 0 ft. to 0 ft., From 0 ft. to 0 ft.

6 GROUT MATERIAL BENTONITE
 Grout Intervals: From 2 ft. to 22 ft., From 0 ft. to 0 ft., From 0 ft. to 0 ft.
 What is the nearest source of possible contamination: SEPTIC TANK
 Direction from well? NORTHEAST How many feet? 5500

FROM	TO	LITHOLOGIC LOG	FROM	TO	PLUGGING INTERVALS
0	5	BROWN CLAY			
5	17	GRAY CLAY			
17	22	TAN CLAY			
22	38	SAND AND GRAVEL			
38	42	RED SANDSTONE			
42	50	RED SHALE			

7 CONTRACTOR'S OR LANDOWNER'S CERTIFICATION: This water well was Constructed under my jurisdiction and was completed on (mo/day/year) 11/09/04 and this record is true to the best of my knowledge and belief. Kansas
 Water Well Contractor's License No. 653 This Water Well Record was completed on (mo/day/yr) 12/13/04
 under the business name of DAN HAYSE WATER WELL SERV by (signature) *Dan Hayse*