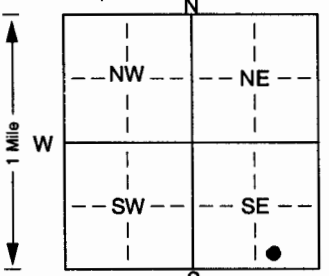


1 LOCATION OF WATER WELL: Fraction **SE 1/4 SE 1/4 SW 1/4** Section Number **35** Township Number **T 34 S** Range Number **R 23 E**
 County: **Clark**

Distance and direction from nearest town or city street address of well if located within city?
1 N + 1/2 W from Acres

2 WATER WELL OWNER: **Frankie Betschart**
 RR#, St. Address, Box # :
 City, State, ZIP Code : **Ashland, KS 67831**
 Board of Agriculture, Division of Water Resources
 Application Number:

3 LOCATE WELL'S LOCATION WITH AN "X" IN SECTION BOX:

 4 DEPTH OF COMPLETED WELL: **210** ft. ELEVATION:
 Depth(s) Groundwater Encountered 1. **42** ft. 2. **42** ft. 3. **30** ft.
 WELL'S STATIC WATER LEVEL **42** ft. below land surface measured on **7-1-00** mo/day/yr
 Pump test data: Well water was **42** ft. after **1** hours pumping **30** gpm
 Est. Yield **50** gpm; Well water was **42** ft. after **1** hours pumping **30** gpm
 Bore Hole Diameter: **8 3/4** in. to **210** ft., and **210** in. to **210** ft.
 WELL WATER TO BE USED AS:
 Domestic 3 Feedlot 6 Oil field water supply 9 Dewatering 11 Injection well
 2 Irrigation 4 Industrial 7 Domestic (lawn & garden) 10 Monitoring well
 Was a chemical/bacteriological sample submitted to Department? Yes No ; If yes, mo/day/yr sample was submitted
 Water Well Disinfected? Yes No

5 TYPE OF BLANK CASING USED:
 1 Steel 3 RMP (SR) 5 Wrought iron 8 Concrete tile CASING JOINTS: Glued Clamped
 PVC 4 ABS 6 Asbestos-Cement 9 Other (specify below) Welded
 7 Fiberglass Threaded
 Blank casing diameter **5** in. to **5** ft., Dia **5** in. to **5** ft., Dia **5** in. to **5** ft.
 Casing height above land surface **18** in., weight **18** lbs./ft. Wall thickness or gauge No. **200A**
 TYPE OF SCREEN OR PERFORATION MATERIAL:
 1 Steel 3 Stainless steel 5 Fiberglass PVC 10 Asbestos-cement
 2 Brass 4 Galvanized steel 6 Concrete tile 8 RMP (SR) 11 Other (specify)
 9 ABS 12 None used (open hole)
 SCREEN OR PERFORATION OPENINGS ARE:
 1 Continuous slot 3 Mill slot 5 Gauzed wrapped 8 Saw cut 11 None (open hole)
 2 Louvered shutter 4 Key punched 6 Wire wrapped 9 Drilled holes
 7 Torch cut 10 Other (specify)
 SCREEN-PERFORATED INTERVALS: From **170** ft. to **210** ft., From **170** ft. to **210** ft., From **170** ft. to **210** ft.
 GRAVEL PACK INTERVALS: From **20** ft. to **210** ft., From **20** ft. to **210** ft., From **20** ft. to **210** ft.

6 GROUT MATERIAL: 1 Neat cement 2 Cement grout 3 Bentonite 4 Other
 Grout Intervals: From **4** ft. to **20** ft., From **4** ft. to **20** ft., From **4** ft. to **20** ft., From **4** ft. to **20** ft.
 What is the nearest source of possible contamination:
 1 Septic tank 4 Lateral lines 7 Pit privy 10 Livestock pens 14 Abandoned water well
 2 Sewer lines 5 Cess pool 8 Sewage lagoon 11 Fuel storage 15 Oil well/Gas well
 3 Watertight sewer lines 6 Seepage pit 9 Feedyard 12 Fertilizer storage 16 Other (specify below)
 13 Insecticide storage
 Direction from well? **E** How many feet? **300**

FROM	TO	LITHOLOGIC LOG	FROM	TO	PLUGGING INTERVALS
0	12	Sandy topsoil			
12	38	brown clay			
38	42	white clay			
42	84	sand + gravel			
84	117	brown clay			
117	210	sand + gravel			

7 CONTRACTOR'S OR LANDOWNER'S CERTIFICATION: This water well was (1) constructed, (2) reconstructed, or (3) plugged under my jurisdiction and was completed on (mo/day/year) **7-3-00** and this record is true to the best of my knowledge and belief. Kansas Water Well Contractor's Licence No. **121** This Water Well Record was completed on (mo/day/yr) **1-15-01** under the business name of **Bartel Well Drilling, Inc.** by (signature) *Reube J. Bartel*