


1 LOCATION OF WATER WELL: Fraction Section Number Township Number Range Number  
 inty: Clark N 1/4 S 6-1/4 E 1/4 1 34 23

Distance and direction from nearest town or city street address of well if located within city?  
5 mi South of Ashland, KS

2 WATER WELL OWNER: Klinger Family  
 RR #, St. Address, Box #: Box 305 Board of Agriculture, Division of Water Resources  
 City, State, ZIP Code: Ashland, KS 67831 Application Number:

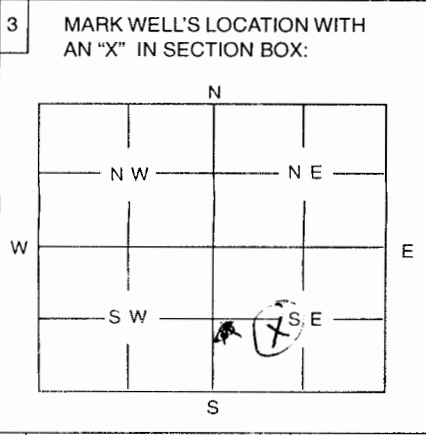

4 DEPTH OF WELL 30 ft  
 WELL'S STATIC WATER LEVEL 15 ft  
 WELL WAS USED AS:  
 1 Domestic 5 Public Water Supply 9 Dewatering  
 2 Irrigation 6 Oil Field Water Supply 10 Monitoring Well  
 3 Feedlot 7 Domestic (Lawn & Garden) 11 Injection Well  
 4 Industrial 8 Air Conditioning 12 Other Livestock  
 Was a chemical / bacteriological sample submitted to Department? Yes No No X  
 If yes, mo/day/yr sample was submitted \_\_\_\_\_  
 Water Well Disinfected: Yes X No \_\_\_\_\_

5 TYPE OF BLANK CASING USED:  
 1 Steel 3 RMP (SR) 5 Wrought 7 Fiberglass 9 Other (Specify below)  
 2 PVC 4 ABS 6 Asbestos-Cement 8 Concrete Tile \_\_\_\_\_  
 Blank casing diameter 5 in. Was casing pulled? Yes \_\_\_\_\_ No X If yes, how much \_\_\_\_\_  
 Casing height above of below land surface 36 in.

6 GROUT PLUG MATERIAL: 1 Neat cement 2 Cement grout 3 Bentonite 4 Other \_\_\_\_\_  
 Grout Plug Intervals: From 3 ft. to 6 ft., From \_\_\_\_\_ ft. to \_\_\_\_\_ ft., From \_\_\_\_\_ to \_\_\_\_\_ ft.  
 What is the nearest source of possible contamination:  
 1 Septic tank 6 Seepage pit 11 Fuel storage 16 Other (specify below) CREEK  
 2 Sewer lines 7 Pit privy 12 Fertilizer storage  
 3 Watertight sewer lines 8 Sewage lagoon 13 Insecticide storage  
 4 Lateral lines 9 Feedyard 14 Abandoned water well  
 5 Cess Pool 10 Livestock pens 15 Oil well/Gas well  
 Direction from well? South How many feet? 15 to 57

FROM	TO	PLUGGING MATERIALS
30	15	Grout
15	6	Subsoil
6	3	Cement
3	0	Topsoil

7 CONTRACTOR'S OR LANDOWNER'S CERTIFICATION: This water well was plugged under my jurisdiction and was completed on (mo/day/year) 7-3-85 and this record is true to the best of my knowledge and belief. Kansas Water Well Contractor's License No. \_\_\_\_\_ This Water Well Record was completed on (mo/day/year) \_\_\_\_\_  
 by (signature) James J. Klinger under the business name of \_\_\_\_\_

INSTRUCTIONS: Use typewriter or ball point pen. Please press firmly and print clearly. Please fill in blanks, underline or circle the correct answers. Send top three copies to Kansas Department of Health and Environment, Bureau of Water, Topeka, Kansas 66620-0001. Telephone: 785/296-3565. Send one to Water Well Owner and retain one for your records.