

CORRECTION(S) TO WATER WELL RECORD (WWC-5)
(to rectify lacking or incorrect information)

County: Clark

Location listed as:

Section-Township-Range: 16-34S-23E

Fraction ($\frac{1}{4}$ $\frac{1}{4}$ $\frac{1}{4}$): NE NE NW

Location changed to:

16-34S-23W

NE NE NW

Other changes: Initial statements: No written description given

Changed to: From Ashland: 6 mi. S., 3.5 mi. W.

Comments: _____

verification method: Legal description, position on plat map, county ownership map, and mapping tool & aerial photo on KGS website. initials: DRB date: 1/27/2009

submitted by: Kansas Geological Survey, Data Resources Library, 1930 Constant Ave., Lawrence, KS 66047-3726
to: Kansas Dept of Health & Environment, Bureau of Water, 1000 SW Jackson, Suite 420, Topeka, KS 66612-1367.


WATER WELL RECORD Form WWC-5 KSA 82a-1212

1 LOCATION OF WATER WELL: Fraction Section Number Township Number Range Number
 COUNTY: CLARK NE 1/4 NE 1/4 NW 1/4 16 T 34 S R 23 E

Distance and direction from nearest town or city street address of well if located within city?

2 WATER WELL OWNER: EUBANKS, TERRY Board of Agriculture, Division of Water Resources
 RR#, St. Address, Box #: BOX 625 Application Number:
 City, State, ZIP code: ASHLAND, KS 67831-

3 LOCATE WELL'S LOCATION WITH AN "X" IN SECTION BOX:

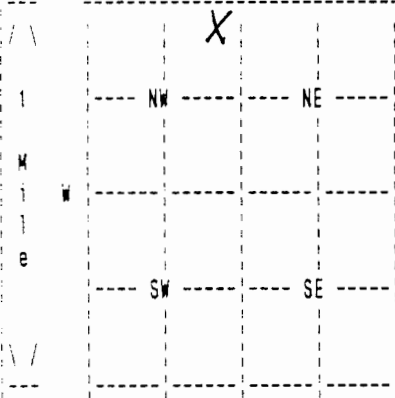

4 DEPTH OF COMPLETED WELL 85 ELEVATION: 0
 Depth(s) Groundwater Encountered 1. 0 ft. 2. 0 ft. 3. 0 ft.
 WELL'S STATIC WATER LEVEL 18 ft. below land surface measured on mo/day/yr 06/23/08
 Pump test data: Well water was 0 ft. after 0 hours pumping 0 gpm
 Estimated Yield 35 gpm: Well water was 0 ft. after 0 hours pumping 0 gpm
 Bore Hole Diameter 10 in. to 85 ft., and in. to 0 ft.
 WELL WATER TO BE USED AS: DOMESTIC
 Was a chemical/bacteriological sample submitted to department? No;
 If yes, mo/day/yr sample was submitted Water well disinfected? Yes

5 TYPE OF BLANK CASING USED: CERTA LOC CASIN CASING JOINTS: CERTA-LOC
 Blank casing diameter 5 in. to 85 ft., Dia in. to 0 ft., Dia in. to 0 ft.
 Casing height above land surface 12 in., weight 200 lbs/ft. Wall thickness or gauge No. 21
 TYPE OF SCREEN OR PERFORATION MATERIAL: PVC
 SCREEN OR PERFORATION OPENINGS ARE: SAW CUT

SCREEN PERFORATED INTERVALS: From 60 ft. to 80 ft., From 0 ft. to 0 ft.
 From 0 ft. to 0 ft., From 0 ft. to 0 ft.
 GRAVEL PACK INTERVALS: From 20 ft. to 85 ft., From 0 ft. to 0 ft.
 From 0 ft. to 0 ft., From 0 ft. to 0 ft.

6 GROUT MATERIAL BENTONITE
 Grout Intervals: From 0 ft. to 20 ft., From 0 ft. to 0 ft., From 0 ft. to 0 ft.
 What is the nearest source of possible contamination: NONE
 Direction from well? How many feet? 0

FROM	TO	LITHOLOGIC LOG	FROM	TO	PLUGGING INTERVALS
0	20	01 TOPSOIL 16 GRAY CLAY 02 FINE SAND			
20	40	02 FINE SAND 05 CLAY 19 LAYERS			
40	60	10 FINE-MEDSAND 05 CLAY 19 LAYERS			
60	80	37 FIN-COAR SAN 33 VERY LOOSE			
80	100	26 RED CLAY			

7 CONTRACTOR'S OR LANDOWNER'S CERTIFICATION: This water well was Constructed under my jurisdiction and was completed on (mo/day/year) 06/23/08 and this record is true to the best of my knowledge and belief. Kansas Water Well Contractor's License No. 179 This Water Well Record was completed on (mo/day/yr) 07/15/08 under the business name of JOE'S WELL SERVICE, INC. by (signature) *Julith Creek*