

USE TYPEWRITER OR BALL POINT PEN-PRESS FIRMLY, PRINT CLEARLY.

WATER WELL RECORD  
KSA 82a-1201-1215


T R EW sec 1/4 1/4 1/4 No.

Kansas State Dept. Of Health  
(Water Well Contractors)  
Forbes-Bldg. 740  
Topeka, Kansas 66620

ACD

1 Location of well:	County <u>Clark</u>	Township name <u>X</u>	Fraction <u>SW 1/4 NE 1/4</u>	Section number <u>19</u>	Town number <u>T34S</u>	Range number <u>R23W</u>
---------------------	------------------------	---------------------------	----------------------------------	-----------------------------	----------------------------	-----------------------------

Distance and direction from nearest town or city: NW Corner of Ashland  
 Street address of well location if in city: 8 So. 4 1/2 W 3/8 So.  
 3 Owner of well: Pine Dry Co.  
 Address: Suite 600-300 W Douglas Wichita, Ks.

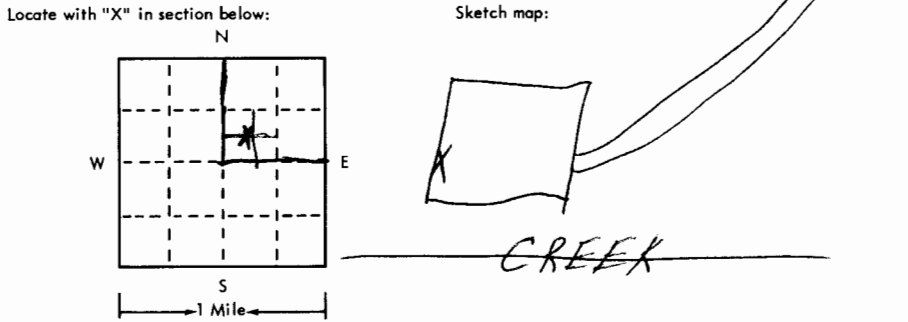

4 Well depth: 85 ft. Date of completion 11/22/75  
 Well diameter 9 in. 5" casing  
 5  Cable tool  Rotary  Driven  Dug  
 Hollow rod  Jetted  Bored  Reverse rotary  
 6 Use:  Domestic  Public supply  Industry  Irrigation  Air conditioning  Commercial  
 Test well   
 7 Casing: Material PVC Height: above 18 in.  
 Threaded  Welded  Surface 18 in.  
 Diam. 6 1/2 in. Weight 200 lbs./ft.  
5 in. to 85 ft. depth Drive shoe?  Yes  No

2	Type and color of material	From	To
	<u>Sur Face</u>	<u>0</u>	<u>2</u>
	<u>Large Sand To Small Sand</u>	<u>2</u>	<u>75</u>
	<u>Red Bud &amp; Green Clay</u>	<u>75</u>	<u>85</u>
	<u>BROCK 75</u>		
	<u>45</u>		
	<u>30's at that</u>		
	<u>Alluvium</u>		

8 Screen: SAWED  
 Manufacturer Cam Tex  
 Type PVC Dia. 5"  
 Slot/gauze 1/16 Length 40  
 Set between 45 ft. and 85 ft.  
 Fittings: Baked Collars  
 Gravel pack  Yes  No Size range of material 1/8"

9 Static water level:  
45 ft. below land surface Date 11/22/75

10 Pumping level below land surfaces:  
NA ft. after 1 hr. pumping g.p.m.  
NA ft. after hrs. pumping g.p.m.  
 Estimated maximum yield \_\_\_\_\_ g.p.m.

11 Water sample submitted:  
 Yes  No Date \_\_\_\_\_

12 Well head completion:  
 Pitless adapter 18 Inches above grade  
 13 Well grouted?  Yes  No  
 Neat cement  Bentonite   
 Depth: From 5 ft. to 15 ft.

14 ~~Water~~ Water ~~is~~ is ~~possible~~ possible ~~contamination~~ contamination  
 Direction SW  
 Disinfect upon completion?  Yes  No

15 Pump:  Not installed  
 Manufacturer's name \_\_\_\_\_  
 Model number \_\_\_\_\_ HP \_\_\_\_\_ Volts \_\_\_\_\_  
 Length of drop pipe \_\_\_\_\_ ft. capacity \_\_\_\_\_ g.m.p.  
 Type:  
 Submersible  Turbine  
 Jet  Reciprocating  
 Centrifugal  Other

16 Remarks: elevation  
 Topography:  
 Hill  
 Slope  
 Upland  
 Valley  
75  
1820

17 Water well contractor's certification:  
 This well was drilled under my jurisdiction and this report is true to the best of my knowledge and belief.  
 Craig Water Well 239  
 Business name \_\_\_\_\_ License No. \_\_\_\_\_  
 Address Box 521 Woodward OK  
 Signed Jerry Big Date 12/4/75  
 Authorized representative

34 R23W 19 S19NE