

USE TYPEWRITER OR BALL POINT PEN-PRESS FIRMLY, PRINT CLEARLY.

WATER WELL RECORD  
KSA 82a-1201-1215


T R EW sec 1/4 1/4 1/4 No.

Kansas State Dept. Of Health  
(Water Well Contractors)  
Forbes-Bldg. 740  
Topeka, Kansas 66620

*112615 11001*

1 Location of well:	County <b>Clark</b>	Township name	Fraction <b>C SW 1/4</b>	Section number <b>7</b>	Town number <b>34S</b>	Range number <b>24W</b>
---------------------	------------------------	---------------	-----------------------------	----------------------------	---------------------------	----------------------------

Distance and direction from nearest town or city: <b>3 1/2 miles north of Englewood and 1/2 Mi. east</b>	3 Owner of well: <b>Sage Drilling Company</b> Address: <b>500 Biting Bldg, Wichita, Kansas 67202</b>
--	---

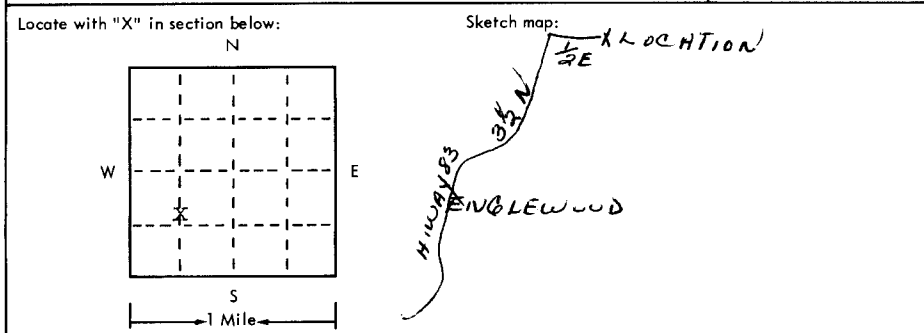

4 Well depth: 120 ft. Date of completion 8-14-75  
Well diameter 9 in.

5  Cable tool  Rotary  Driven  Dug  
 Hollow rod  Jetted  Bored  Reverse rotary

6 Use:  Domestic  Public supply  Industry  
 Irrigation  Air conditioning  Commercial  
 Test well  oil rig

7 Casing: Material PVC Height: above/below  
Threaded  Welded  Surface 28 in.  
Diam. 5 in. Weight 2.78 lbs./ft.  
5 in. to 80 ft. depth Drive shoe?  Yes  No  
59 in. to 120 ft. depth

2	Type and color of material	From	To
	Surface	0	2
	Fine sand	2	24
	Sandy clay	24	68
	Coarse sand	68	110
	Coarse sand (hard drilling) <b>RED BED</b>	110	120
	<b>BRICK 110</b> <u>17</u> <u>93' sat thick</u>		
	<b>in Alluvium</b> (use a second sheet if needed)		

8 Screen:  
Manufacturer sawed perf.  
Type PVC Dia. 5  
Slot/gauze .030 Length 30  
Set between 80 ft. and 110 ft.  
Fittings: 1/8- 3/16  
Gravel pack  Yes  No Size range of material \_\_\_\_\_

9 Static water level:  
17 ft. below land surface Date 8-14-75

10 Pumping level below land surfaces:  
\_\_\_\_ ft. after \_\_\_\_ hrs. pumping \_\_\_\_ g.p.m.  
\_\_\_\_ ft. after \_\_\_\_ hrs. pumping \_\_\_\_ g.p.m.  
Estimated maximum yield 70 g.p.m.

11 Water sample submitted:  
 Yes  No Date \_\_\_\_\_

12 Well head completion:  
 Pitless adapter 28 inches above grade

13 Well grouted?  Yes  No  
 Neat cement  Bentonite  \_\_\_\_\_  
Depth: From 0 ft. to 10 ft.

14 Nearest source of possible contamination:  
ft. 100 Direction NE Type oil well  
Well disinfected upon completion?  Yes  No

15 Pump:  Not installed  
Manufacturer's name \_\_\_\_\_  
Model number \_\_\_\_\_ HP \_\_\_\_\_ Volts \_\_\_\_\_  
Length of drop pipe \_\_\_\_\_ ft. capacity \_\_\_\_\_ g.m.p.  
Type:  
 Submersible  Turbine  
 Jet  Reciprocating  
 Centrifugal  Other

16 Remarks: elevation

Topography:  
 Hill  
 Slope  
 Upland  
 Valley

17 Water well contractor's certification:  
This well was drilled under my jurisdiction and this report is true to the best of my knowledge and belief.  
Carlile Water Well 118  
Business name \_\_\_\_\_ License No. \_\_\_\_\_  
Address Box 275, Liberal, Ks.  
Signed \_\_\_\_\_ Date 8-22-75  
Authorized representative

*34 24W 7 25W*