


GARDNER

1 LOCATION OF WATER WELL: County: CLARK Fraction: C 1/4 NE 1/4 SW 1/4 Section Number: 8 Township Number: T 34 S Range Number: R 24 EW

Distance and direction from nearest town or city street address of well if located within city? ENGLEWOOD 3N 1 1/2 E NORTHSIDE WATER WELL OWNER: D.R. LAUCK OIL CO. INC. RR#, St. Address, Box #: 221 S. BROADWAY SUITE 400 City, State, ZIP Code: WICHITA, KS. 67202. Board of Agriculture, Division of Water Resources Application Number: T83-635

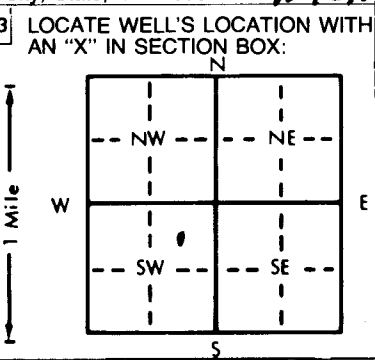

3 LOCATE WELL'S LOCATION WITH AN 'X' IN SECTION BOX: 4 DEPTH OF COMPLETED WELL: 90 ft. ELEVATION: ... WELL'S STATIC WATER LEVEL: 2.3 ft. below land surface measured on mo/day/yr 11-11-83

5 TYPE OF BLANK CASING USED: 1 Steel, 2 PVC, 3 RMP (SR), 4 ABS, 5 Wrought iron, 6 Asbestos-Cement, 7 Fiberglass, 8 Concrete tile, 9 Other (specify below), 10 Observation well, 11 Injection well, 12 Other (Specify below). CASING JOINTS: Glued, Clamped, Welded, Threaded. Blank casing diameter: 5 in. to 7.0 ft., Dia. Casing height above land surface: 12 in., weight 2.65 lbs./ft. Wall thickness or gauge No. 7.14

6 GROUT MATERIAL: 1 Neat cement, 2 Cement grout, 3 Bentonite, 4 Other. Grout Intervals: From 0 ft. to 10 ft. What is the nearest source of possible contamination: NONE. 5 Gauzed wrapped, 6 Wire wrapped, 7 Torch cut, 8 Saw cut, 9 Drilled holes, 10 Other (specify), 11 None (open hole). SCREEN OR PERFORATION OPENINGS ARE: 1 Continuous slot, 2 Louvered shutter, 3 Mill slot, 4 Key punched, 5 Fiberglass, 6 Concrete tile, 7 RMP (SR), 8 ABS, 9 ABS, 10 Other (specify), 11 None (open hole). SCREEN-PERFORATED INTERVALS: From 7.0 ft. to 9.0 ft. GRAVEL PACK INTERVALS: From 2.3 ft. to 9.0 ft.

Direction from well? How many feet? LITHOLOGIC LOG table with columns FROM, TO, LITHOLOGIC LOG. Entries: 0-12 SAND, 12-35 CLAY, 35-40 SANDY CLAY, 40-90 GRAVEL.

7 CONTRACTOR'S OR LANDOWNER'S CERTIFICATION: This water well was (1) constructed, (2) reconstructed, or (3) plugged under my jurisdiction and was completed on (mo/day/year) 11-11-83 and this record is true to the best of my knowledge and belief. Kansas Water Well Contractor's License No. 389. This Water Well Record was completed on (mo/day/year) 11-18-83 under the business name of NELSER WATER WELL SERV. INC. by (signature) Rudolph M... INSTRUCTIONS: Use typewriter or ball point pen, PLEASE PRESS FIRMLY and PRINT clearly. Please fill in blanks, underline or circle the correct answers. Send top three copies to Kansas Department of Health and Environment, Division of Environment, Environmental Geology Section, Topeka, KS 66620. Send one to WATER WELL OWNER and retain one for your records.

OFFICE USE ONLY

T 34

R 24

EW

SEC. 8

C 1/4 NE 1/4 SW 1/4

8