WATER WELL RECORD Form WWC-5 KSA 82a-1212

1 LOCATION OF WATER WELL: County: Clark	Fraction: SW ¼ SW ¼ NW ¼	Section Number: 23	Township Number: T 34 S	Range Number: R 25 E/W

Distance and direction from nearest town or city street address of well if located within city?
2 North, 1½ West of Englewood, Ks.

2 WATER WELL OWNER: Sharon Rooney
RR#, St. Address, Box # :
City, State, ZIP Code : Minneola, Ks. 67865 Well #1, East Well

Board of Agriculture, Division of Water Resources Application Number: ---

3 LOCATE WELL'S LOCATION WITH AN "X" IN SECTION BOX:

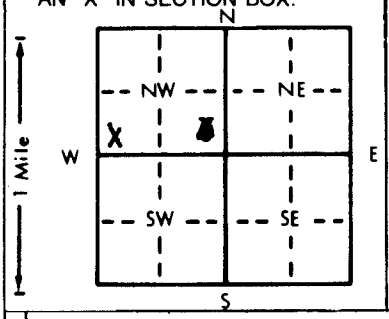

4 DEPTH OF COMPLETED WELL 187 ft. ELEVATION: Slope
Depth(s) Groundwater Encountered 1. 110 ft. 2. ft. 3. ft.
WELL'S STATIC WATER LEVEL 91 ft. below land surface measured on mo/day/yr
Pump test data: Well water was ft. after hours pumping gpm
Est. Yield 30-50 gpm: Well water was ft. after hours pumping gpm
Bore Hole Diameter 9 7/8 in. to 187 ft., and in. to ft.
WELL WATER TO BE USED AS: 5 Public water supply 8 Air conditioning 11 Injection well
(1) Domestic 3 Feedlot 6 Oil field water supply 9 Dewatering XX Other (Specify below)
2 Irrigation 4 Industrial 7 Lawn and garden only 10 Observation well Stock
Was a chemical/bacteriological sample submitted to Department? Yes ..... No ....XX...; If yes, mo/day/yr sample was submitted
Water Well Disinfected? Yes XXX No

5 TYPE OF BLANK CASING USED: 5 Wrought iron 8 Concrete tile CASING JOINTS: Glued XXX Clamped
1 Steel 3 RMP (SR) 6 Asbestos-Cement 9 Other (specify below) Welded
XX PVC 4 ABS 7 Fiberglass Threaded
Blank casing diameter 5 in. to 127 ft., Dia in. to ft., Dia in. to ft.
Casing height above land surface 24 XX in., weight 2.8 lbs./ft. Wall thickness or gauge No. .265
TYPE OF SCREEN OR PERFORATION MATERIAL: XX PVC 10 Asbestos-cement
1 Steel 3 Stainless steel 5 Fiberglass 8 RMP (SR) 11 Other (specify)
2 Brass 4 Galvanized steel 6 Concrete tile 9 ABS 12 None used (open hole)
SCREEN OR PERFORATION OPENINGS ARE: 5 Gauzed wrapped XX Saw cut 11 None (open hole)
1 Continuous slot 3 Mill slot 6 Wire wrapped 9 Drilled holes
2 Louvered shutter 4 Key punched 7 Torch cut 10 Other (specify)
SCREEN-PERFORATED INTERVALS: From 127 ft. to 187 ft., From ft. to ft.
From ft. to ft., From ft. to ft.
GRAVEL PACK INTERVALS: From 10 ft. to 187 ft., From ft. to ft.
From ft. to ft., From ft. to ft.

6 GROUT MATERIAL: XX Neat cement 2 Cement grout 3 Bentonite 4 Other
Grout Intervals: From 0 ft. to 10 ft., From ft. to ft., From ft. to ft.
What is the nearest source of possible contamination: 10 Livestock pens 14 Abandoned water well
1 Septic tank 4 Lateral lines 7 Pit privy 11 Fuel storage XX 5 Oil well/Gas well
2 Sewer lines 5 Cess pool 8 Sewage lagoon 12 Fertilizer storage 16 Other (specify below)
3 Watertight sewer lines 6 Seepage pit 9 Feedyard 13 Insecticide storage
Direction from well? Northwest How many feet? 1200

FROM	TO	LITHOLOGIC LOG	FROM	TO	LITHOLOGIC LOG
0	20	Fine Sand			
20	25	Clay			
25	60	Fine to Med. Sand			
60	110	Clay w/Streaks of Sand			
110	178	Fine to Med. Sand w/Streaks of Clay			
178	188	Red Bed			

7 CONTRACTOR'S OR LANDOWNER'S CERTIFICATION: This water well was (1) constructed, (2) reconstructed, or (3) plugged under my jurisdiction and was completed on (mo/day/year) July 30, 1982 and this record is true to the best of my knowledge and belief. Kansas Water Well Contractor's License No. 252 This Water Well Record was completed on (mo/day/yr) August 24, 1982 under the business name of Friesen Windmill & Supply Inc. by (signature)

INSTRUCTIONS: Use typewriter or ball point pen, *PLEASE PRESS FIRMLY* and *PRINT* clearly. Please fill in blanks, underline or circle the correct answers. Send top three copies to Kansas Department of Health and Environment, Division of Environment, Environmental Geology Section, Topeka, KS 66620. Send one to WATER WELL OWNER and retain one for your records.

OFFICE USE ONLY
T 34 R 25 E/W SEC. 23 SW¼ SW¼ NW¼
Jul 3 | 40