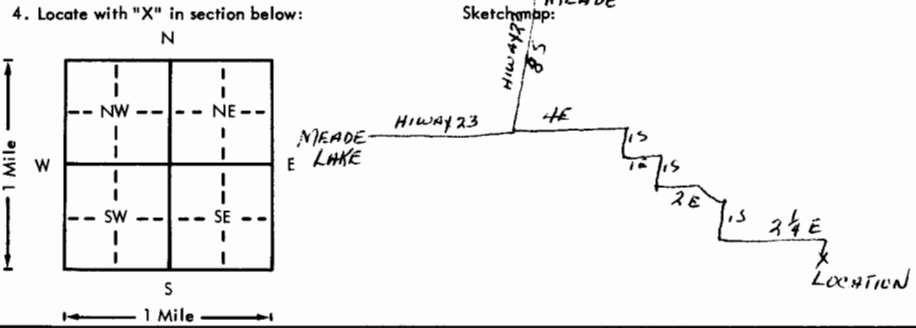


USE TYPEWRITER OR BALL
POINT PEN-PRESS FIRMLY,
PRINT CLEARLY.

WATER WELL RECORD
KSA 82a-1201-1215

Kansas Department of Health and
Environment-Division of Environment
(Water well Contractors)
Topeka, Kansas 66620

Inv. # 11968

1. Location of well:	County Meade	Fraction 1/4 NW 1/4 NW 1/4	Section number 5	Township number T 34	Range number S R 26
2. Distance and direction from nearest town or city: 8 miles south of Meade, 4E 1S 1E, 1S 2E 1S 2E			3. Owner of well: Rains & Williamson Oil Co., Inc. R.R. or street: 435 Page Court, 220 West Douglas City, state, zip code: Wichita, Kansas 67202		
4. Locate with "X" in section below: 			6. Bore hole dia. 9 in. Completion date 1-13-76 Well depth 140 ft.		
5. Type and color of material			7. <input checked="" type="checkbox"/> Cable tool <input checked="" type="checkbox"/> Rotary <input type="checkbox"/> Driven <input type="checkbox"/> Dug <input type="checkbox"/> Hollow rod <input type="checkbox"/> Jetted <input type="checkbox"/> Bored <input type="checkbox"/> Reverse rotary		
Surface			8. Use: <input type="checkbox"/> Domestic <input type="checkbox"/> Public supply <input type="checkbox"/> Industry <input type="checkbox"/> Irrigation <input type="checkbox"/> Air conditioning <input type="checkbox"/> Stock <input type="checkbox"/> Lawn <input checked="" type="checkbox"/> Oil field water <input type="checkbox"/> Other		
Clay and fine sand 90-10			9. Casing: Material <input type="checkbox"/> Height: Above or below Threaded <input type="checkbox"/> Welded <input type="checkbox"/> Surface 28 in. RMP <input type="checkbox"/> PVC <input checked="" type="checkbox"/> Weight 2.78 lbs./ft. Dia. 5 in. to 65 ft. depth Wall Thickness: inches or Dia. 5 in. to 140 ft. depth gage No. 265		
Clay and medium to large sand 80-20			10. Screen: Manufacturer's name sawed perf. Type PVC Dia. 5" Slot/gauze .030 Length 70 Set between 65 ft. and 135 ft. ft. and 135 ft. and 135 ft. Gravel pack? yes Size range of material 1/8 to 3/16		
Fine sand and medium to large sand			11. Static water level: 68 ft. below land surface Date 1-13-76		
Medium to large sand and redbed 85-130			12. Pumping level below land surfaces: ft. after 0 hrs. pumping 30 g.p.m. ft. after 0 hrs. pumping 30 g.p.m. Estimated maximum yield 30 g.p.m.		
Medium to large sand and redbed 50-50			13. Water sample submitted: Yes <input checked="" type="checkbox"/> No <input type="checkbox"/> Date 1-13-76		
			14. Well head completion: 28 inches above grade		
			15. Well grouted? Yes With: <input checked="" type="checkbox"/> Neat cement <input type="checkbox"/> Bentonite <input type="checkbox"/> Concrete Depth: From 0 ft. to 10 ft.		
			16. Nearest source of possible contamination: 100 ft. Direction ne Type oilwell Well disinfected upon completion? <input checked="" type="checkbox"/> Yes <input type="checkbox"/> No		
			17. Pump: <input checked="" type="checkbox"/> Not installed Manufacturer's name Carlile Water Well Model number 118 HP 1 Volts 115 Length of drop pipe 140 ft. capacity 30 g.p.m. Type: <input type="checkbox"/> Submersible <input type="checkbox"/> Turbine <input type="checkbox"/> Jet <input type="checkbox"/> Reciprocating <input type="checkbox"/> Centrifugal <input type="checkbox"/> Other		
18. Elevation:			20. Water well contractor's certification: This well was drilled under my jurisdiction and this report is true to the best of my knowledge and belief. Carlile Water Well 118 Business name Box 275, Liberal, Ks. License No. 1-29 Address Edward E. Means Date 1-29 Signed Edward E. Means Authorized representative		
19. Remarks: meade location					

Forward the white, blue and pink copies to the Department of Health and Environment

Form WWC-5