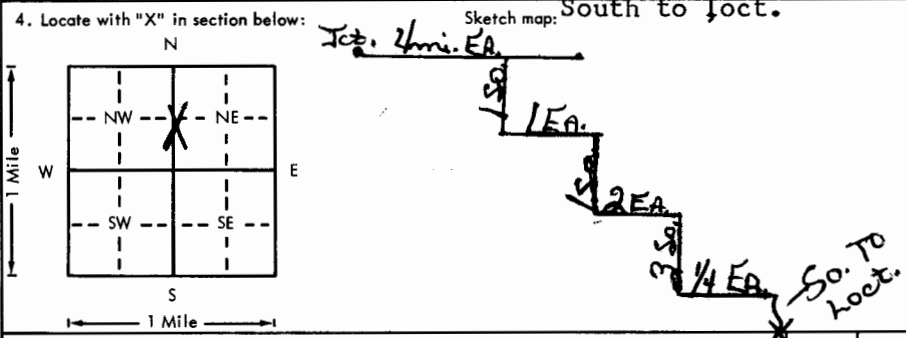


USE TYPEWRITER OR BALL
POINT PEN-PRESS FIRMLY,
PRINT CLEARLY.

WATER WELL RECORD
KSA 82a-1201-1215

Kansas Department of Health and
Environment-Division of Environment
(Water well Contractors)
Topeka, Kansas 66620

CWW Inv. #12986

1. Location of well:	County Meade	Fraction Center No. $\frac{1}{2}$ $\frac{1}{4}$ $\frac{1}{4}$	Section number 13	Township number T 34 S	Range number R 27 E/W
2. Distance and direction from nearest town or city: From Jct. Ea. a6 Meade 1k. go 4 mi. Ea - 1 mi. So. - 1 mi. Ea. 1 mi. So. - 2 mi. Ea. - 3 mi. So. - $\frac{1}{4}$ mi. Ea			3. Owner of well: Zenith Drilling Company R.R. or street: Suite 600, 200 W. Douglas City, state, zip code: Wichita, KS 67202		
4. Locate with "X" in section below: 			6. Bore hole dia. 9 1/2 in. Completion date 12/13 Well depth 220 ft.		
5. Type and color of material			7. <input type="checkbox"/> Cable tool <input checked="" type="checkbox"/> Rotary <input type="checkbox"/> Driven <input type="checkbox"/> Dug <input type="checkbox"/> Hollow rod <input type="checkbox"/> Jetted <input type="checkbox"/> Bored <input type="checkbox"/> Reverse rotary		
8. Use: <input type="checkbox"/> Domestic <input type="checkbox"/> Public supply <input checked="" type="checkbox"/> Industry <input type="checkbox"/> Irrigation <input type="checkbox"/> Air conditioning <input type="checkbox"/> Stock <input type="checkbox"/> Lawn <input checked="" type="checkbox"/> Oil field water <input type="checkbox"/> Other			9. Casing: Material <input type="checkbox"/> Height: Above or below Threaded <input type="checkbox"/> Welded <input type="checkbox"/> Surface 28 in. RMP <input type="checkbox"/> PVC <input checked="" type="checkbox"/> Weight 2.78 lbs./ft. Dia. 5 in. to 215 ft. depth Wall Thickness: inches or Dia. 5 in. to 220 ft. depth gage No. 265		
10. Screens: Manufacturer's name Saved Perf.			11. Static water level: 135 ft. below land surface Date 12/13		
12. Pumping level below land surfaces: ft. after 0 hrs. pumping 60 g.p.m. ft. after 0 hrs. pumping 60 g.p.m. Estimated maximum yield 60 g.p.m.			13. Water sample submitted: Yes <input checked="" type="checkbox"/> No <input type="checkbox"/> Date 12/13		
14. Well head completion: <input type="checkbox"/> Pitless adapter 28 inches above grade			15. Well grouted? yes With: <input checked="" type="checkbox"/> Neat cement <input type="checkbox"/> Bentonite <input type="checkbox"/> Concrete Depth: From 0 ft. to 10 ft.		

18. Elevation: 2429 Topography: Thm <input type="checkbox"/> Hill <input type="checkbox"/> Slope <input checked="" type="checkbox"/> Upland <input type="checkbox"/> Valley			19. Remarks: 2429 135 2294		
20. Water well contractor's certification: This well was drilled under my jurisdiction and this report is true to the best of my knowledge and belief. Carlile Water Wells 118 Business name License No. Address Box 275, Liberal, KS Signed Edward E. Means Date 12/13 Authorized representative					

Forward the white, blue and pink copies to the Department of Health and Environment

Form WWC-5