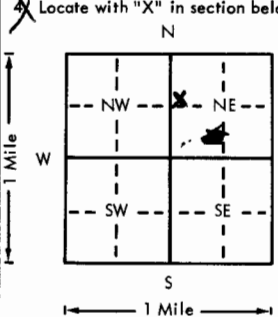



USE TYPEWRITER OR BALL  
POINT PEN-PRESS FIRMLY,  
PRINT CLEARLY.

WATER WELL RECORD  
KSA 82a-1201-1215

Kansas Department of Health and  
Environment-Division of Environment  
(Water well Contractors)  
Topeka, Kansas 66620

Inish flots SE

|   |  |   |  |  |                               |                            |
|---|--|---|--|--|-------------------------------|----------------------------|
| X Location of well:   |  | County <u>Meade</u>   | Fraction <u>SW 1/4 NE 1/4</u>                    | Section number <u>18</u>   | Township number <u>T 34 S</u> | Range number <u>R 27 E</u> |
| Distance and direction from nearest town or city: <u>135- 4 1/2 E of Meade</u>  |  |   | 3. Owner of well: <u>Alfred Barby</u>            |  |                               |                            |
| Street address of well location if in city:   |  |   | City, state, zip code: <u>Meade Kansas 67864</u> |  |                               |                            |
| X Locate with "X" in section below:   |  | Sketch map:   |  | 6. Bore hole dia. <u>8 1/2</u> in. Completion date <u>3-14-78</u>  |                               |                            |
|   |  |  |  | Well depth <u>140</u> ft.  |                               |                            |
| 5. Type and color of material   |  | From To   |  | 7. Cable tool <input checked="" type="checkbox"/> Rotary <input type="checkbox"/> Driven <input type="checkbox"/> Dug <input type="checkbox"/> Hollow rod <input type="checkbox"/> Jetted <input type="checkbox"/> Bored <input type="checkbox"/> Reverse rotary   |                               |                            |
| <u>Topsoil</u>  |  | <u>0 5</u>  |  | 8. Use: <input type="checkbox"/> Domestic <input type="checkbox"/> Public supply <input type="checkbox"/> Industry <input type="checkbox"/> Irrigation <input type="checkbox"/> Air conditioning <input checked="" type="checkbox"/> Stock <input type="checkbox"/> Lawn <input type="checkbox"/> Oil field water <input type="checkbox"/> Other |                               |                            |
| <u>fine sand</u>  |  | <u>6 75</u>   |  | 9. Casing: Material <u>PVC</u> Height: Above or below  |                               |                            |
| <u>white clay</u>   |  | <u>76 126</u>   |  | Threaded <input type="checkbox"/> Welded <input type="checkbox"/> Surface <u>12</u> in.  |                               |                            |
| <u>gravel</u>   |  | <u>127 134</u>  |  | RMP <input type="checkbox"/> PVC <input checked="" type="checkbox"/> Weight <u>200</u> lbs./ft.  |                               |                            |
| <u>redbed</u>   |  | <u>135 140</u>  |  | Dia. <u>5</u> in. to <u>140</u> ft. depth Wall Thickness: inches or  |                               |                            |
|   |  |   |  | Dia. <u>5</u> in. to <u>140</u> ft. depth gage No. <u>118</u>  |                               |                            |
|   |  |   |  | 10. Screen: Manufacturer's name <u>Sunflower</u>   |                               |                            |
|   |  |   |  | Type <u>PVC</u> Dia. <u>5</u>  |                               |                            |
|   |  |   |  | Slot/gauze <u>1/4</u> Length <u>20</u>   |                               |                            |
|   |  |   |  | Set between <u>140</u> ft. and <u>120</u> ft.  |                               |                            |
|   |  |   |  | Gravel pack? <input checked="" type="checkbox"/> Size range of material <u>1/4-4</u>   |                               |                            |
|   |  |   |  | 11. Static water level: <u>118</u> ft. below land surface Date <u>3-14-78</u>  |                               |                            |
|   |  |   |  | 12. Pumping level below land surfaces:   |                               |                            |
|   |  |   |  | ft. after <u>1 1/2</u> hrs. pumping <u>10</u> g.p.m.   |                               |                            |
|   |  |   |  | ft. after <u>15</u> hrs. pumping <u>15</u> g.p.m.  |                               |                            |
|   |  |   |  | Estimated maximum yield <u>15</u> g.p.m.   |                               |                            |
|   |  |   |  | 13. Water sample submitted: <u>Yes</u> <input checked="" type="checkbox"/> No <input type="checkbox"/> Date <u>3-14-78</u>   |                               |                            |
|   |  |   |  | 14. Well head completion: <u>see note</u>  |                               |                            |
|   |  |   |  | <input type="checkbox"/> Pitless adapter <u>145</u> inches above grade   |                               |                            |
|   |  |   |  | 15. Well grouted? <input checked="" type="checkbox"/>  |                               |                            |
|   |  |   |  | With: <input type="checkbox"/> Neat cement <input type="checkbox"/> Bentonite <input checked="" type="checkbox"/> Concrete   |                               |                            |
|   |  |   |  | Depth: From <u>0</u> ft. to <u>140</u> ft.   |                               |                            |
|   |  |   |  | 16. Nearest source of possible contamination: <u>200</u> ft. Direction <u>West</u> Type <u>West</u>  |                               |                            |
|   |  |   |  | Well disinfected upon completion? <input type="checkbox"/> Yes <input type="checkbox"/> No   |                               |                            |
|   |  |   |  | 17. Pump: <input type="checkbox"/> Not installed   |                               |                            |
|   |  |   |  | Manufacturer's name <u>Baritel Dily</u>  |                               |                            |
|   |  |   |  | Model number <u>101A</u> HP <u>10</u> Volts <u>115</u>   |                               |                            |
|   |  |   |  | Length of drop pipe <u>140</u> ft. capacity <u>10</u> g.p.m.   |                               |                            |
|   |  |   |  | Type: <input type="checkbox"/> Submersible <input type="checkbox"/> Turbine <input type="checkbox"/> Jet <input type="checkbox"/> Reciprocating <input type="checkbox"/> Centrifugal <input type="checkbox"/> Other  |                               |                            |
| 18. Elevation: <u>2350</u> ftm  |  | 19. Remarks: <u>Windmill stock well</u>   |  | 20. Water well contractor's certification:   |                               |                            |
| Topography: <u>2350</u><br><u>118</u><br><u>2232</u>  |  |   |  | This well was drilled under my jurisdiction and this report is true to the best of my knowledge and belief.  |                               |                            |
| <input type="checkbox"/> Hill <input checked="" type="checkbox"/> Slope <input type="checkbox"/> Upland <input type="checkbox"/> Valley |  |   |  | Business name <u>Baritel Dily</u> License No. <u>101A</u>  |                               |                            |
|   |  |   |  | Address <u>Meade Kansas</u>  |                               |                            |
|   |  |   |  | Signed <u>Robt. P. Baritel</u> Date <u>3-26-78</u>   |                               |                            |
|   |  |   |  | Authorized representative  |                               |                            |

Forward the white, blue and pink copies to the Department of Health and Environment

Form WWC-5