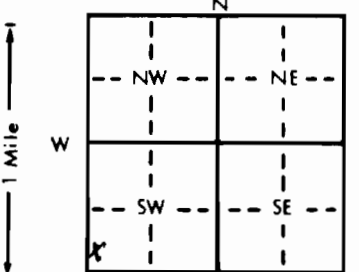


1 LOCATION OF WATER WELL: County: <u>Meade</u>	Fraction <u>SW 1/4 SW 1/4 SW 1/4</u>	Section Number <u>35</u>	Township Number T <u>34</u> S	Range Number R <u>28</u> EW
---	---	-----------------------------	----------------------------------	--------------------------------

Distance and direction from nearest town or city street address of well if located within city?

1834 16 3/4 miles south of Meade

2 WATER WELL OWNER: <u>Otis Meredith</u> RR#, St. Address, Box #: <u>16140 DD Road</u> City, State, ZIP Code: <u>Meade, KS 67864</u>	Board of Agriculture, Division of Water Resources Application Number:
--	--

3 LOCATE WELL'S LOCATION WITH AN "X" IN SECTION BOX: 	4 DEPTH OF COMPLETED WELL: <u>72</u> ft. ELEVATION: Depth(s) Groundwater Encountered 1. ft. 2. ft. 3. ft. WELL'S STATIC WATER LEVEL <u>71</u> ft. below land surface measured on mo/day/yr Pump test data: Well water was ft. after hours pumping gpm Est. Yield gpm: Well water was ft. after hours pumping gpm Bore Hole Diameter in. to ft., and in. to ft. WELL WATER TO BE USED AS: ☒ 1 Domestic ☐ 2 Irrigation ☐ 3 Feedlot ☐ 4 Industrial ☐ 5 Public water supply ☐ 6 Oil field water supply ☐ 7 Lawn and garden only ☐ 8 Air conditioning ☐ 9 Dewatering ☐ 10 Monitoring well ☐ 11 Injection well ☐ 12 Other (Specify below) Was a chemical/bacteriological sample submitted to Department? Yes No ☒ If yes, mo/day/yr sample was submitted Water Well Disinfected? Yes ☒ No
--	--

5 TYPE OF BLANK CASING USED: ☒ 1 Steel ☐ 2 PVC ☐ 3 RMP (SR) ☐ 4 ABS Blank casing diameter <u>4</u> in. to ft., Dia in. to ft., Dia in. to ft. Casing height above land surface <u>3' below</u> in., weight lbs./ft. Wall thickness or gauge No.	☐ 5 Wrought iron ☐ 6 Asbestos-Cement ☐ 7 Fiberglass CASING JOINTS: Glued Clamped ☐ 8 Concrete tile ☐ 9 Other (specify below) ☐ Welded ☐ 10 Asbestos-cement ☐ 11 Other (specify) ☐ 12 None used (open hole)
TYPE OF SCREEN OR PERFORATION MATERIAL: ☐ 1 Steel ☐ 2 Brass ☐ 3 Stainless steel ☐ 4 Galvanized steel ☐ 5 Fiberglass ☐ 6 Concrete tile ☐ 7 PVC ☐ 8 RMP (SR) ☐ 9 ABS ☐ 10 Asbestos-cement ☐ 11 Other (specify) SCREEN OR PERFORATION OPENINGS ARE: ☐ 1 Continuous slot ☐ 2 Louvered shutter ☐ 3 Mill slot ☐ 4 Key punched ☐ 5 Gauzed wrapped ☐ 6 Wire wrapped ☐ 7 Torch cut ☐ 8 Saw cut ☐ 9 Drilled holes ☐ 10 Other (specify) SCREEN-PERFORATED INTERVALS: From ft. to ft., From ft. to ft., From ft. to ft. GRAVEL PACK INTERVALS: From ft. to ft., From ft. to ft., From ft. to ft.	

6 GROUT MATERIAL: ☒ 1 Neat cement ☐ 2 Cement grout ☐ 3 Bentonite ☐ 4 Other Grout intervals: From ft. to ft., From ft. to ft., From ft. to ft. What is the nearest source of possible contamination: ☐ 1 Septic tank ☐ 2 Sewer lines ☐ 3 Watertight sewer lines ☐ 4 Lateral lines ☐ 5 Cess pool ☐ 6 Seepage pit ☐ 7 Pit privy ☐ 8 Sewage lagoon ☐ 9 Feedyard ☒ 10 Livestock pens ☐ 11 Fuel storage ☐ 12 Fertilizer storage ☐ 13 Insecticide storage ☐ 14 Abandoned water well ☐ 15 Oil well/Gas well ☐ 16 Other (specify below) Direction from well? How many feet?
--

FROM	TO	LITHOLOGIC LOG	FROM	TO	PLUGGING INTERVALS
			<u>72</u>	<u>71</u>	<u>chlorinated sand</u>
			<u>71</u>	<u>6</u>	<u>compacted soils</u>
			<u>6</u>	<u>3</u>	<u>neat cement</u>
			<u>3</u>		<u>cut off casing and backfill</u>

7 CONTRACTOR'S OR LANDOWNER'S CERTIFICATION: This water well was (1) constructed, (2) reconstructed, or (3) plugged under my jurisdiction and was completed on (mo/day/year) <u>2-18-97</u> and this record is true to the best of my knowledge and belief. Kansas Water Well Contractor's License No. <u>003</u> This Water Well Record was completed on (mo/day/yr) <u>2-25-97</u> under the business name of by (signature) <u>Otis Meredith</u>
