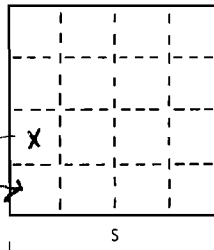
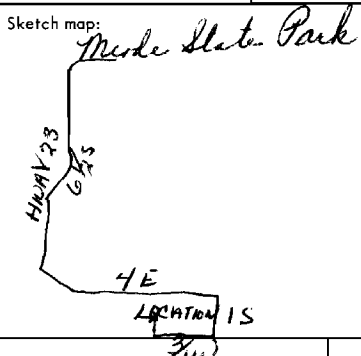
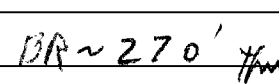


USE TYPEWRITER OR BALL
POINT PEN-PRESS FIRMLY,
PRINT CLEARLY.

T R EW sec 1/4 1/4 1/4 No.

WATER WELL RECORD
KSA 82a-1201-1215

Kansas State Dept. Of Health
(Water Well Contractors)
Forbes-Bldg. 740
Topeka, Kansas 66620

1 Location of well:	County Meade	Township name	Fraction C SW SW	Section number 31	Town number 34S	Range number 28W
Distance and direction from nearest town or city: 6.5 S Meade Lake, 4E, 1S, 3/4W & N into location. Street address of well location if in city:				3 Owner of well: Rains & Williamson Oil Co. Address: 435 Page Court, 220 West Douglas Wichita, Kansas 67202		
Locate with "X" in section below: N  W E S 1 Mile		Sketch map: 		4 Well depth: 280 ft. Date of completion 9-25-75 Well diameter 9 in.		
2 Type and color of material		From	To	5 <input type="checkbox"/> Cable tool <input checked="" type="checkbox"/> Rotary <input type="checkbox"/> Driven <input type="checkbox"/> Dug <input type="checkbox"/> Hollow rod <input type="checkbox"/> Jetted <input type="checkbox"/> Bored <input type="checkbox"/> Reverse rotary		
Surface		0	2	6 Use: <input type="checkbox"/> Domestic <input type="checkbox"/> Public supply <input checked="" type="checkbox"/> Industry <input type="checkbox"/> Irrigation <input type="checkbox"/> Air conditioning <input type="checkbox"/> Commercial <input type="checkbox"/> Test well <input type="checkbox"/> Oil Rig		
Fine to medium sand		2	22	7 Casing: Material PVC Height: above/below Threaded <input type="checkbox"/> Welded <input type="checkbox"/> Surface 28 in. Diam. 2.78 lbs./ft. 5 in. to 200 ft. depth Drive shoe? <input type="checkbox"/> Yes <input checked="" type="checkbox"/> No 5 in. to 280 ft. depth		
Sandy clay		22	100	8 Screen: Manufacturer sawed perf. Type PVC Dia. 5 Slot/gauze .030 Length 70 Set between 200 ft. and 270 ft. Fittings: 1/8 to 3/16 Gravel pack <input checked="" type="checkbox"/> Yes <input type="checkbox"/> No Size range of material		
Fine to medium sand & sandy clay 40-60		100	120	9 Static water level: 160 ft. below land surface Date 9-25-75		
Medium to large sand		120	140	10 Pumping level below land surfaces: ____ ft. after ____ hrs. pumping ____ g.p.m. ____ ft. after ____ hrs. pumping ____ g.p.m. Estimated maximum yield 15 g.p.m.		
Medium to large sand & sandy clay 80-20		140	270	11 Water sample submitted: <input type="checkbox"/> Yes <input checked="" type="checkbox"/> No Date		
Medium to large sand and redbed 80-20		270	280	12 Well head completion: <input type="checkbox"/> Pitless adapter 28 inches above grade		
DR ~ 270' 				13 Well grouted? <input checked="" type="checkbox"/> Yes <input type="checkbox"/> No <input checked="" type="checkbox"/> Neat cement <input type="checkbox"/> Bentonite <input type="checkbox"/> Depth: From 0 ft. to 10 ft.		
				14 Nearest source of possible contamination: ft. 100 Direction NE Type oil well Well disinfected upon completion? <input checked="" type="checkbox"/> Yes <input type="checkbox"/> No		
				15 Pump: <input checked="" type="checkbox"/> Not installed Manufacturer's name Model number HP Volts Length of drop pipe ft. capacity g.m.p. Type: <input type="checkbox"/> Submersible <input type="checkbox"/> Turbine <input type="checkbox"/> Jet <input type="checkbox"/> Reciprocating <input type="checkbox"/> Centrifugal <input type="checkbox"/> Other		
16 Remarks: elevation		17 Water well contractor's certification: This well was drilled under my jurisdiction and this report is true to the best of my knowledge and belief. Carlile Water Well 118 Business name License No. Address Box 275, Liberal, Kansas Signed Edward & Means Date 10-3-75 Authorized representative				
Topography: <input type="checkbox"/> Hill <input type="checkbox"/> Slope <input checked="" type="checkbox"/> Upland <input type="checkbox"/> Valley						

Forward the white, blue and pink copies to the Kansas State Dept. Of Health.

Form WWC-5