


1 LOCATION OF WATER WELL: Fraction SE 1/4 SE 1/4 SE 1/4 Section Number 12 Township Number T 34 S Range Number R 29 **EW**
 County: Meade

Distance and direction from nearest town or city street address of well if located within city? Meade, Kansas - 13 miles South - 4 miles West into.

2 WATER WELL OWNER: Bill Larrabee
 RR#, St. Address, Box #: 1211 N Pershing Board of Agriculture, Division of Water Resources
 City, State, ZIP Code: Liberal, KS 67901 Application Number:

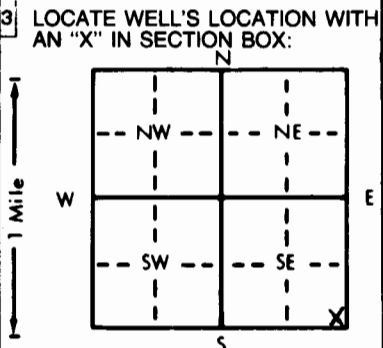

4 DEPTH OF COMPLETED WELL: 160' ft. ELEVATION:
 Depth(s) Groundwater Encountered 1. 89 ft. 2. ft. 3. ft.
 WELL'S STATIC WATER LEVEL 89 ft. below land surface measured on mo/day/yr 06/15/88
 Pump test data: Well water was ft. after hours pumping gpm
 Est. Yield gpm: Well water was ft. after hours pumping gpm
 Bore Hole Diameter: 9 in. to 16.0 ft., and in. to ft.
 WELL WATER TO BE USED AS:
 1 Domestic (circled) 3 Feedlot 6 Oil field water supply 9 Dewatering 12 Other (Specify below) pasture tank
 2 Irrigation 4 Industrial 7 Lawn and garden only 10 Observation well
 Was a chemical/bacteriological sample submitted to Department? Yes.....No.....; If yes, mo/day/yr sample was submitted
 Water Well Disinfected? Yes X No

5 TYPE OF BLANK CASING USED:
 1 Steel 3 RMP (SR) 5 Wrought iron 8 Concrete tile CASING JOINTS: Glued Clamped
 2 PVC (circled) 4 ABS 6 Asbestos-Cement 9 Other (specify below) Welded
 7 Fiberglass Threaded
 Blank casing diameter 5.563 in. to 100 ft., Dia. in. to ft., Dia. in. to ft.
 Casing height above land surface 28 in., weight 2.93 lbs./ft. Wall thickness or gauge No. 265
 TYPE OF SCREEN OR PERFORATION MATERIAL:
 1 Steel 3 Stainless steel 5 Fiberglass 7 PVC (circled) 10 Asbestos-cement
 2 Brass 4 Galvanized steel 6 Concrete tile 9 ABS 11 Other (specify)
 12 None used (open hole)
 SCREEN OR PERFORATION OPENINGS ARE:
 1 Continuous slot 3 Mill slot 5 Gauzed wrapped 8 Saw cut (circled) 11 None (open hole)
 2 Louvered shutter 4 Key punched 6 Wire wrapped 9 Drilled holes
 7 Torch cut 10 Other (specify)
 SCREEN-PERFORATED INTERVALS: From 100 ft. to 160 ft., From ft. to ft.
 From ft. to ft., From ft. to ft.
 GRAVEL PACK INTERVALS: From 27 ft. to 38 ft., From 48 ft. to 160 ft.
 From ft. to ft., From ft. to ft.

6 GROUT MATERIAL: 1 Neat cement (circled) 2 Cement grout 3 Bentonite (circled) 4 Other
 Grout Intervals: From 5 ft. to 7 ft., From 7 ft. to 27 ft., From 38 ft. to 48 ft.
 What is the nearest source of possible contamination:
 1 Septic tank 4 Lateral lines 7 Pit privy 10 Livestock pens 14 Abandoned water well
 2 Sewer lines 5 Cess pool 8 Sewage lagoon 11 Fuel storage 15 Oil well/Gas well
 3 Watertight sewer lines 6 Seepage pit 9 Feedyard 12 Fertilizer storage 16 Other (specify below) stock tank
 13 Insecticide storage
 Direction from well? Northwest How many feet? 60'

FROM	TO	LITHOLOGIC LOG	FROM	TO	LITHOLOGIC LOG
0	2	Surface			
2	28	Sandy Clay			
28	37	Caliche			
37	42	Med. to large sand			
42	48	Clay			
48	74	30% Clay - 70% Fine Sand			
74	96	Sandy Clay			
96	107	70% Med. to large sand - 30% Sandy Clay			
107	152	Med. to large sand			
152	160	Red Bed			

7 CONTRACTOR'S OR LANDOWNER'S CERTIFICATION: This water well was (1) constructed, (2) reconstructed, or (3) plugged under my jurisdiction and was completed on (mo/day/year) 06/15/88 and this record is true to the best of my knowledge and belief. Kansas Water Well Contractor's License No. 118 This Water Well Record was completed on (mo/day/yr) 06/21/88 under the business name of Carlile Water Well Service, Inc. by (signature) [Signature]

INSTRUCTIONS: Use typewriter or ball point pen. PLEASE PRESS FIRMLY and PRINT clearly. Please fill in blanks, underline or circle the correct answers. Send top three copies to Kansas Department of Health and Environment, Bureau of Water Protection, Topeka, Kansas 66620-7320, Telephone: 913-862-9360. Send one to WATER WELL OWNER and retain one for your records.

OFFICE USE ONLY
T
R
EW
SEC.
1/4
1/4