


1 LOCATION OF WATER WELL: County: Meade	Fraction 1/4 C-NW 1/4 SE 1/4	Section Number 30	Township Number T 34 S	Range Number R 29 EW
---	--	-----------------------------	----------------------------------	--------------------------------

Distance and direction from nearest town or city street address of well if located within city? **Go East on Meade Lake Road to caution Light then 2mi East 7mi South 2mi East North to location.**

2 WATER WELL OWNER: **Nielson Enterprises**
 RR#, St. Address, Box # : **c/o Harold Frauli Box 1634**
 City, State, ZIP Code : **Liberal, Kansas 67901**
 Board of Agriculture, Division of Water Resources
 Application Number: **T 81-662**

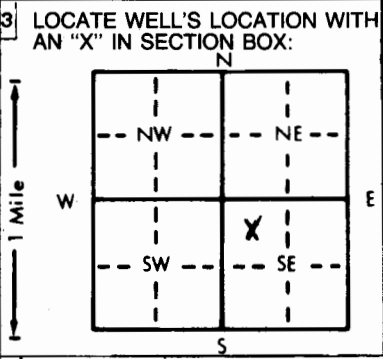

4 DEPTH OF COMPLETED WELL: **300** ft. ELEVATION: _____ ft.
 Depth(s) Groundwater Encountered 1. **160** ft. 2. _____ ft. 3. _____ ft.
 WELL'S STATIC WATER LEVEL **140** ft. below land surface measured on mo/day/yr **9/21/81**
 Pump test data: Well water was _____ ft. after _____ hours pumping _____ gpm
 Est. Yield **60** gpm: Well water was _____ ft. after _____ hours pumping _____ gpm
 Bore Hole Diameter **9** in. to **300** ft., and _____ in. to _____ ft.
 WELL WATER TO BE USED AS:
 5 Public water supply 8 Air conditioning 11 Injection well
 1 Domestic 3 Feedlot 6 Oil field water supply 9 Dewatering 12 Other (Specify below)
 2 Irrigation 4 Industrial 7 Lawn and garden only 10 Observation well
 Was a chemical/bacteriological sample submitted to Department? Yes _____ No _____; If yes, mo/day/yr sample was submitted _____
 Water Well Disinfected? Yes _____ No _____

5 TYPE OF BLANK CASING USED:
 1 Steel 3 RMP (SR) 5 Wrought iron 8 Concrete tile CASING JOINTS: Glued _____ Clamped _____
 2 PVC 4 ABS 6 Asbestos-Cement 9 Other (specify below) _____ Welded _____
 7 Fiberglass _____ Threaded _____
 Blank casing diameter **5** in. to **220** ft., Dia _____ in. to _____ ft., Dia _____ in. to _____ ft.
 Casing height above land surface **28** in., weight **2.78** lbs./ft. Wall thickness or gauge No. **256**
 TYPE OF SCREEN OR PERFORATION MATERIAL:
 1 Steel 3 Stainless steel 5 Fiberglass 7 PVC 10 Asbestos-cement
 2 Brass 4 Galvanized steel 6 Concrete tile 8 RMP (SR) 11 Other (specify) _____
 9 ABS 12 None used (open hole)
 SCREEN OR PERFORATION OPENINGS ARE:
 1 Continuous slot 3 Mill slot 5 Gauzed wrapped 8 Saw cut 11 None (open hole)
 2 Louvered shutter 4 Key punched 6 Wire wrapped 9 Drilled holes
 7 Torch cut 10 Other (specify) _____
 SCREEN-PERFORATED INTERVALS: From **220** ft. to **300** ft., From _____ ft. to _____ ft.
 GRAVEL PACK INTERVALS: From **120** ft. to **300** ft., From _____ ft. to _____ ft.

6 GROUT MATERIAL: 1 Neat cement 2 Cement grout 3 Bentonite 4 Other _____
 Grout intervals: From **0** ft. to **10** ft., From _____ ft. to _____ ft., From _____ ft. to _____ ft.
 What is the nearest source of possible contamination:
 1 Septic tank 1 4 Lateral lines 7 Pit privy 1 10 Livestock pens 14 Abandoned water well
 2 Sewer lines 5 Cess pool 8 Sewage lagoon 11 Fuel storage 15 Oil well/Gas well
 3 Watertight sewer lines 6 Seepage pit 9 Feedyard 12 Fertilizer storage 16 Other (specify below)
 13 Insecticide storage
 Direction from well? **Northeast of water well** How many feet? **100**

FROM	TO	LITHOLOGIC LOG	FROM	TO	LITHOLOGIC LOG
0	2	surface			
2	24	sandy clay			
24	38	claiche			
38	72	sandy clay			
72	110	blue clay			
110	160	clay			
160	190	sandy clay			
190	235	blue clay			
235	242	sandy clay			
242	290	medium to large sand			
290	300	blue clay			

7 CONTRACTOR'S OR LANDOWNER'S CERTIFICATION: This water well was (1) constructed, (2) reconstructed, or (3) plugged under my jurisdiction and was completed on (mo/day/year) **September 21, 1981** and this record is true to the best of my knowledge and belief. Kansas Water Well Contractor's License No. **118**. This Water Well Record was completed on (mo/day/yr) **Sept. 30, 1981** under the business name of **Carlile Water Well Service, Inc.** by (signature) *Edward E. Means*

INSTRUCTIONS: Use typewriter or ball point pen, PLEASE PRESS FIRMLY and PRINT clearly. Please fill in blanks, underline or circle the correct answers. Send top three copies to Kansas Department of Health and Environment, Division of Environment, Environmental Geology Section, Topeka, KS 66620. Send one to WATER WELL OWNER and retain one for your records.

OFFICE USE ONLY
T 34 R 29 EW SEC 30 1/4 NW 1/4 SE 1/4