

USE TYPEWRITER OR BALL POINT PEN-PRESS FIRMLY, PRINT CLEARLY.

T R EW sec 1/4 1/4 1/4 No.

WATER WELL RECORD
KSA 82a-1201-1215

Kansas State Dept. Of Health
(Water Well Contractors)
Forbes-Bldg. 740
Topeka, Kansas 66620


Adams #1-3

Inv. # 10977

All spot on diagram
Each plot

1 Location of well:	County Meade	Township name	Fraction NE-NE	Section number 33	Town number 34S	Range number 29W
---------------------	------------------------	---------------	--------------------------	-----------------------------	---------------------------	----------------------------

Distance and direction from nearest town or city: **9 miles So. of Meade State Park**
Street address of well location if in city: _____
3 Owner of well: **Sterling Drilling Co.**
% Dick Meade
Address: **Box 129 Sterling, Kansas 67579**

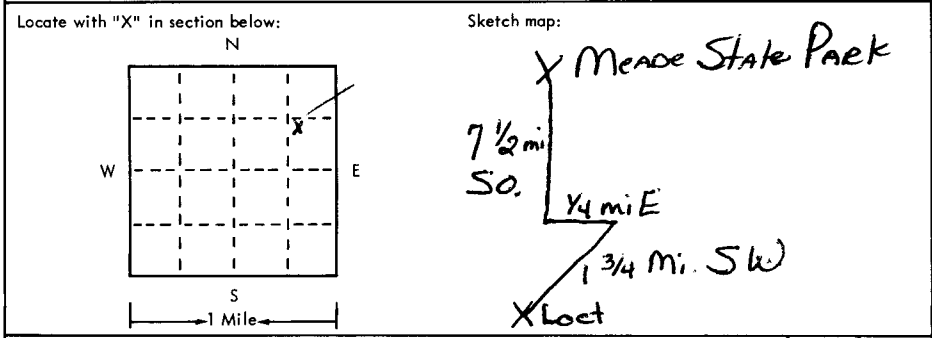

4 Well depth: **380** ft. Date of completion **1-17-75**
Well diameter **9** in.

5 Cable tool Rotary Driven Dug
 Hollow rod Jetted Bored Reverse rotary

6 Use: Domestic Public supply Industry
 Irrigation Air conditioning Commercial
 Test well **Oil Well**

7 Casing: Material **PVC** Height: above/below
Threaded Welded Surface **12** in.
Diam. _____ Weight **278** lbs./ft. _____
5 1/2 in. to **330** ft. depth Drive shoe? Yes No
5 1/2 in. to **380** ft. depth!

2	Type and color of material	From	To
	Surface	0	2
	Brown Clay	2	15
	Fine Sand	15	20
	Brown Clay	20	38
	Blue Clay & White Sandstone	38	56
	Brown Clay	56	77
	Blue Clay	77	117
	Brown & Blue Clay	117	138
	Brown Clay w/sand streaks (wear)	138	159
	Brown Clay	159	324
	Small to Medium Sand & Gravel	324	340
	Brown Clay, Caliche Rock, Sand & Gravel	340	360
	Brown Clay w/sand & gravel	360	380

8 Screen:
Manufacturer **Wesco**
Type **PVC** Dia. **5 1/2**
Slot/gauze **.030** Length **10**
Set between **330** ft. and **340** ft.
Fittings:
Gravel pack Yes No Size range of material _____

9 Static water level:
132 ft. below land surface Date **1-17-75**

10 Pumping level below land surfaces:
_____ ft. after _____ hrs. pumping _____ g.p.m.
_____ ft. after _____ hrs. pumping _____ g.p.m.
Estimated maximum yield **50** g.p.m.

11 Water sample submitted:
 Yes No Date _____

12 Well head completion:
 Pitless adapter **12** inches above grade

13 Well grouted? Yes No
 Neat cement Bentonite _____
Depth: From **0** ft. to **10** ft.

14 Nearest source of possible contamination:
ft. **100** Direction **SW** Type **Oil Well**
Well disinfected upon completion? Yes No

15 Pump: Not installed
Manufacturer's name _____
Model number _____ HP _____ Volts _____
Length of drop pipe _____ ft. capacity _____ g.m.p.
Type:
 Submersible Turbine
 Jet Reciprocating
 Centrifugal Other

16 Remarks: elevation

Topography:
 Hill
 Slope
 Upland
 Valley

Capped and Turned over to
Mr. Dave Adams
Adams Ranch
NI y Route
Meades, Kansas

17 Water well contractor's certification:
This well was drilled under my jurisdiction and this report is true to the best of my knowledge and belief.
Carlile Water Well 118
Business name License No.
Address **Box 275 Liberal, Ks.**
Signed **Edward E. Means** Date **1-21-75**
Authorized representative