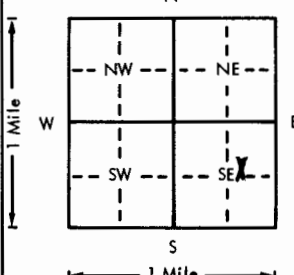
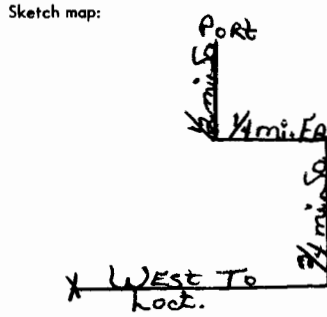


USE TYPEWRITER OR BALL  
POINT PEN-PRESS FIRMLY,  
PRINT CLEARLY.

WATER WELL RECORD  
KSA 82a-1201-1215

Kansas Department of Health and  
Environment-Division of Environment  
(Water well Contractors)  
Topeka, Kansas 66620

CWW Inv. #12939

1. Location of well:		County <b>Meade</b>	Fraction <b>C</b> SW 1/4 NE 1/4 SE 1/4	Section number <b>33</b>	Township number <b>T 34 S</b>	Range number <b>R 29 E</b>
2. Distance and direction from nearest town or city: <b>From Port So. of Meade Lake go 1/2 mi. So. - 1/4 mi. Ea. - 3/4 mi. So. &amp; we. into lock.</b>		3. Owner of well: <b>Triad Drilling Co.</b> R.R. or street: <b>1100 Bitting Bldg.</b> City, state, zip code: <b>Wichita, KS 67202</b>				
4. Locate with "X" in section below: 		Sketch map: 		6. Bore hole dia. <b>9</b> in. Completion date <b>12/4</b> Well depth <b>100</b> ft.		
5. Type and color of material		From	To	7. <input type="checkbox"/> Cable tool <input checked="" type="checkbox"/> Rotary <input type="checkbox"/> Driven <input type="checkbox"/> Dug <input type="checkbox"/> Hollow rod <input type="checkbox"/> Jetted <input type="checkbox"/> Bored <input type="checkbox"/> Reverse rotary		
Surface		0	2	8. Use: <input type="checkbox"/> Domestic <input type="checkbox"/> Public supply <input checked="" type="checkbox"/> Industry <input type="checkbox"/> Irrigation <input type="checkbox"/> Air conditioning <input type="checkbox"/> Stock <input type="checkbox"/> Lawn <input checked="" type="checkbox"/> Oil field water <input type="checkbox"/> Other		
Clay		2	40	9. Casing: Material <input type="checkbox"/> Height: Above or below Threaded <input type="checkbox"/> Welded <input type="checkbox"/> Surface <b>28</b> in. RMP <input type="checkbox"/> PVC <input checked="" type="checkbox"/> Weight <b>2.78</b> lbs./ft. Dia. <b>5</b> in. to <b>320</b> ft. depth Wall Thickness: inches or Dia. <b>5</b> in. to <b>100</b> ft. depth gage No. <b>265</b>		
Fine Sand		40	65	10. Screen: Manufacturer's name <b>S. Sawed Perf.</b> Type <b>PVC</b> Dia. <b>5 1/2</b> Slot/gauze <b>.030</b> Length <b>70</b> Set between <b>320</b> ft. and <b>390</b> ft. ft. and ft. Gravel pack? <b>yes</b> Size range of material <b>1/8-3/16</b>		
Clay		65	180	11. Static water level: <b>170</b> ft. below land surface Date <b>12/4/76</b> mo./day/yr.		
Sandy Clay		180	333	12. Pumping level below land surfaces: ft. after hrs. pumping g.p.m. ft. after hrs. pumping g.p.m. Estimated maximum yield <b>45</b> g.p.m.		
Medium to large sand		333	400	13. Water sample submitted: <b>Yes</b> <input checked="" type="checkbox"/> No <input type="checkbox"/> Date		
				14. Well head completion: <input type="checkbox"/> Pitless adapter <b>28</b> inches above grade		
				15. Well grouted? <b>yes</b> With: <input checked="" type="checkbox"/> Neat cement <input type="checkbox"/> Bentonite <input type="checkbox"/> Concrete Depth: From <b>0</b> ft. to <b>10</b> ft.		
				16. Nearest source of possible contamination: ft. <b>100</b> Direction <b>NE</b> Type <b>oil well</b> Well disinfected upon completion? <input checked="" type="checkbox"/> Yes <input type="checkbox"/> No		
				17. Pump: <input checked="" type="checkbox"/> Not installed Manufacturer's name Model number HP Volts Length of drop pipe ft. capacity g.p.m. Type: <input type="checkbox"/> Submersible <input type="checkbox"/> Turbine <input type="checkbox"/> Jet <input type="checkbox"/> Reciprocating <input type="checkbox"/> Centrifugal <input type="checkbox"/> Other		
18. Elevation: <b>2507</b> ft Topography: <input type="checkbox"/> Hill <input type="checkbox"/> Slope <input checked="" type="checkbox"/> Upland <input type="checkbox"/> Valley		19. Remarks: <b>2507</b> <b>170</b> <b>2331</b>		20. Water well contractor's certification: This well was drilled under my jurisdiction and this report is true to the best of my knowledge and belief. <b>Carlile Water Well Ser. 118</b> Business name License No. Address <b>Box 275 Liberal, KS</b> Signed <b>Edward E. Means</b> Date Authorized representative		

Forward the white, blue and pink copies to the Department of Health and Environment

Form WWC-5