

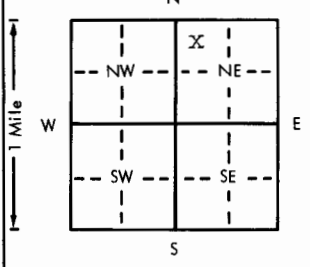
USE TYPEWRITER OR BALL  
POINT PEN-PRESS FIRMLY,  
PRINT CLEARLY.

WATER WELL RECORD  
KSA 82a-1201-1215

Kansas Department of Health and  
Environment-Division of Environment  
(Water well Contractors)  
Topeka, Kansas 66620

CWW Inv. #13600

*Irish flats*

1. Location of well:		County <b>Meade</b>	Fraction <b>B A</b> 1/4 NW 1/4 NE 1/4	Section number <b>35</b>	Township number <b>T 34S</b>	Range number <b>S R 29 W E/W</b>
2. Distance and direction from nearest town or city: <b>From Port of Entry So. of Meade Lk, go 1/2 mi. So., 1 1/2 mi. Ea. and South to location.</b>			3. Owner of well: <b>Sage Drilling co.</b> R.R. or street: <b>500 Bitting Building</b> City, state, zip code: <b>Wichita, KS 67202</b>			
4. Locate with "X" in section below:		Sketch map:		6. Bore hole dia. <b>9</b> in. Completion date <b>6/28/77</b> Well depth <b>300</b> ft.		
				7. <input checked="" type="checkbox"/> Cable tool <input checked="" type="checkbox"/> Rotary <input type="checkbox"/> Driven <input type="checkbox"/> Dug <input type="checkbox"/> Hollow rod <input type="checkbox"/> Jetted <input type="checkbox"/> Bored <input type="checkbox"/> Reverse rotary		
5. Type and color of material		From		To		8. Use: <input type="checkbox"/> Domestic <input type="checkbox"/> Public supply <input checked="" type="checkbox"/> Industry <input type="checkbox"/> Irrigation <input type="checkbox"/> Air conditioning <input type="checkbox"/> Stock <input type="checkbox"/> Lawn <input checked="" type="checkbox"/> Oil field water <input type="checkbox"/> Other
Surface		0		2		9. Casing: Material <input type="checkbox"/> Height: Above or below Threaded <input type="checkbox"/> Welded <input type="checkbox"/> Surface <b>28</b> in. RMP <input type="checkbox"/> PVC <input checked="" type="checkbox"/> Weight <b>2.78</b> lbs./ft. Dia. <b>5</b> in. to <b>190</b> ft. depth Wall Thickness: inches or Dia. <b>5</b> in. to <b>300</b> ft. depth gage No. <b>265</b>
Clay		2		50		10. Screen: Manufacturer's name <b>Sawed perf.</b> Type <b>PVC</b> Dia. <b>5"</b> Slot/gauze <b>.030</b> Length <b>80"</b> Set between <b>190</b> ft. and <b>270</b> ft. ft. and ft. Gravel pack <b>yes</b> Size range of material <b>1/8-3/16</b>
Sandy clay		50		90		11. Static water level: <b>165</b> ft. below land surface Date <b>6/28/77</b> mo./day/yr.
Fine Sand & medium to large sand, 70-30		90		260		12. Pumping level below land surfaces: ft. after hrs. pumping g.p.m. ft. after hrs. pumping g.p.m. Estimated maximum yield <b>50</b> g.p.m.
Redbed		260		300		13. Water sample submitted: <b>yes</b> mo./day/yr. Yes <input checked="" type="checkbox"/> No <input type="checkbox"/> Date
						14. Well head completion: Pitless adapter <b>28</b> inches above grade
						15. Well grouted? <b>yes</b> With: <input checked="" type="checkbox"/> Neat cement <input type="checkbox"/> Bentonite <input type="checkbox"/> Concrete Depth: From <b>0</b> ft. to <b>10</b> ft.
						16. Nearest source of possible contamination: ft. <b>100</b> Direction <b>NE</b> Type <b>oil well</b> Well disinfected upon completion? <input checked="" type="checkbox"/> Yes <input type="checkbox"/> No
						17. Pump: <input checked="" type="checkbox"/> Not installed Manufacturer's name Model number HP Volts Length of drop pipe ft. capacity g.p.m. Type: <input type="checkbox"/> Submersible <input type="checkbox"/> Turbine <input type="checkbox"/> Jet <input type="checkbox"/> Reciprocating <input type="checkbox"/> Centrifugal <input type="checkbox"/> Other
18. Elevation: <b>2501</b>		19. Remarks:		20. Water well contractor's certification: This well was drilled under my jurisdiction and this report is true to the best of my knowledge and belief. <b>Carlile Water Well's</b> <b>118</b> Business name License No. Address <b>Box 275, Liberal, KS</b> Signed <b>Edward E. Means</b> Date <b>7/12</b> Authorized representative		