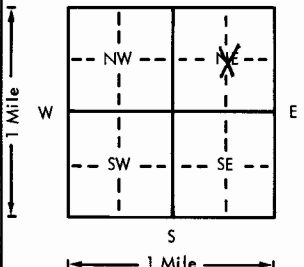


USE TYPEWRITER OR BALL
POINT PEN-PRESS FIRMLY,
PRINT CLEARLY.

WATER WELL RECORD
KSA 82a-1201-1215

Kansas Department of Health and
Environment-Division of Environment
(Water well Contractors)
Topeka, Kansas 66620

CWW Inv. #12937

1. Location of well:		County <u>Meade</u>	Fraction <u>1/4-NE 1/4 NE 1/4</u>	Section number <u>4</u>	Township number <u>T 34 S</u>	Range number <u>R 30 E</u>
2. Distance and direction from nearest town or city: <u>Go Ea. on Meade</u> <u>lk. rd. to Plains Jct. then 3 1/4 mi. So. -</u> Street address of well location if in city: <u>West to loc.</u>				3. Owner of well: <u>Rine Drilling Co.</u> R.R. or street: <u>Suite 600, 300 W. Douglas</u> City, state, zip code: <u>Wichita, KS 67202</u>		
4. Locate with "X" in section below:		Sketch map:		6. Bore hole dia. <u>9</u> in. Completion date <u>12/3</u> Well depth <u>280</u> ft.		
				7. <input type="checkbox"/> Cable tool <input checked="" type="checkbox"/> Rotary <input type="checkbox"/> Driven <input type="checkbox"/> Dug <input type="checkbox"/> Hollow rod <input type="checkbox"/> Jetted <input type="checkbox"/> Bored <input type="checkbox"/> Reverse rotary		
5. Type and color of material		From	To	8. Use: <input type="checkbox"/> Domestic <input type="checkbox"/> Public supply <input checked="" type="checkbox"/> Industry <input type="checkbox"/> Irrigation <input type="checkbox"/> Air conditioning <input type="checkbox"/> Stock <input type="checkbox"/> Lawn <input checked="" type="checkbox"/> Oil field water <input type="checkbox"/> Other		
<u>Surface</u>		<u>0</u>	<u>2</u>	9. Casing: Material <input type="checkbox"/> Height: <u>Above</u> or below Threaded <input type="checkbox"/> Welded <input type="checkbox"/> Surface <u>28</u> in. RMP <input type="checkbox"/> PVC <input checked="" type="checkbox"/> Weight <u>2.78</u> lbs./ft. Dia. <u>5</u> in. to <u>175</u> ft. depth Wall Thickness: inches or Dia. <u>5</u> in. to <u>280</u> ft. depth gage No. <u>265</u>		
<u>Clay</u>		<u>2</u>	<u>70</u>	10. Screen: Manufacturer's name <u>Sawed perf.</u> Type <u>PVC</u> Dia. <u>5"</u> Slot/gauze <u>.030</u> Length <u>100'</u> Set between <u>175</u> ft. and <u>275</u> ft. _____ ft. and _____ ft. Gravel pack? <u>YES</u> Size range of material <u>1/8-3/16</u>		
<u>Fine sand & med. to lge. sand</u>		<u>70</u>	<u>230</u>	11. Static water level: <u>180</u> ft. below land surface Date <u>12/3/76</u> mo./day/yr.		
<u>Clay & fine sand</u>		<u>230</u>	<u>245</u>	12. Pumping level below land surfaces: _____ ft. after _____ hrs. pumping _____ g.p.m. _____ ft. after _____ hrs. pumping _____ g.p.m. Estimated maximum yield <u>40</u> g.p.m.		
<u>Clay & fine sand</u>		<u>245</u>	<u>263</u>	13. Water sample submitted: _____ mo./day/yr. <input type="checkbox"/> Yes <input checked="" type="checkbox"/> No Date _____		
<u>Clay and fine sand</u>		<u>263</u>	<u>280</u>	14. Well head completion: <input type="checkbox"/> Pitless adapter <u>28</u> inches above grade		
				15. Well grouted? <u>yes</u> With: <input checked="" type="checkbox"/> Neat cement <input type="checkbox"/> Bentonite <input type="checkbox"/> Concrete Depth: From <u>0</u> ft. to <u>10</u> ft.		
				16. Nearest source of possible contamination: ft. <u>100</u> Direction <u>NE</u> Type <u>oilwell</u> Well disinfected upon completion? <input checked="" type="checkbox"/> Yes <input type="checkbox"/> No		
				17. Pump: <input checked="" type="checkbox"/> Not installed Manufacturer's name _____ Model number _____ HP _____ Volts _____ Length of drop pipe _____ ft. capacity _____ g.p.m. Type: <input type="checkbox"/> Submersible <input type="checkbox"/> Turbine <input type="checkbox"/> Jet <input type="checkbox"/> Reciprocating <input type="checkbox"/> Centrifugal <input type="checkbox"/> Other		
				(Use a second sheet if needed)		
18. Elevation:		19. Remarks:		20. Water well contractor's certification: This well was drilled under my jurisdiction and this report is true to the best of my knowledge and belief. <u>Carlile Water Well Ser. 118</u> Business name _____ License No. _____ Address <u>Box 275 Liberal, KS</u> Signed <u>Edward E. Means</u> Date _____ Authorized representative		
Topography: <input type="checkbox"/> Hill <input type="checkbox"/> Slope <input checked="" type="checkbox"/> Upland <input type="checkbox"/> Valley						

34
320
4
CNE NE
1/4 1/4 1/4