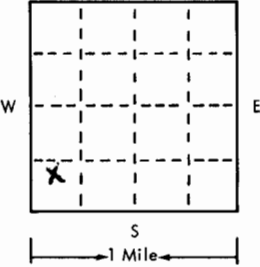
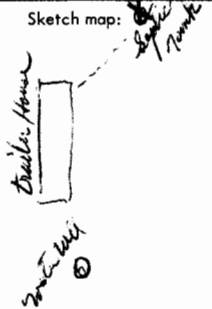


USE TYPEWRITER OR BALL
POINT PEN-PRESS FIRMLY,
PRINT CLEARLY.

WATER WELL RECORD
KSA 82a-1201-1215

T R EW sec 1/4 1/4 1/4 No.

Kansas State Dept. Of Health
(Water Well Contractors)
Forbes-Bldg. 740
Topeka, Kansas 66620

1 Location of well:	County MEADE	Township name CIMARRON	Fraction S.W. 1/4 SW 1/4	Section number 4	Town number T34S	Range number R30W
Distance and direction from nearest town or city: 10 MILES SOUTH PLAINS, KANS.				3 Owner of well: CARL RAY BOND Address: PLAINS KANSAS		
Locate with "X" in section below: 				Sketch map: 		
2 Type and color of material				From	To	4 Well depth: 300 ft. Date of completion 3/3/75 Well diameter 5 in.
HARD SANDY CLAY				1	40	5 <input type="checkbox"/> Cable tool <input checked="" type="checkbox"/> Rotary <input type="checkbox"/> Driven <input type="checkbox"/> Dug <input type="checkbox"/> Hollow rod <input type="checkbox"/> Jetted <input type="checkbox"/> Bored <input type="checkbox"/> Reverse rotary
SAND				40	42	6 Use: <input checked="" type="checkbox"/> Domestic <input type="checkbox"/> Public supply <input type="checkbox"/> Industry <input type="checkbox"/> Irrigation <input type="checkbox"/> Air conditioning <input type="checkbox"/> Commercial <input type="checkbox"/> Test well <input type="checkbox"/>
SANDY CLAY				42	60	7 Casing: Material Steel Height: above/below Threaded <input type="checkbox"/> Welded <input checked="" type="checkbox"/> Surface 36 in. Diam. 5 in. to 300 ft. depth Drive shoe? <input type="checkbox"/> Yes <input checked="" type="checkbox"/> No Weight 320 lbs./ft.
HARD CLAY AND ROCK				60	80	8 Screen: Sanflow plastic of Wichita Falls Manufacturer Sanflow Type 12 Dia. 40 Slot/gauze 12 Length 40 Set between 260 ft. and 300 ft. Fittings: Gravel pack <input checked="" type="checkbox"/> Yes <input type="checkbox"/> No Size range of material 1/8
GRAY SANDY CLAY				80	180	9 Static water level: 175 ft. below land surface Date 3/3/75
GRAY AND BLUE CLAY				180	200	10 Pumping level below land surfaces: 180 ft. after 3 hrs. pumping 19 g.p.m. ____ ft. after ____ hrs. pumping ____ g.p.m. Estimated maximum yield ____ g.p.m.
FINE TO MEDIUM SAND				200	240	11 Water sample submitted: <input type="checkbox"/> Yes <input checked="" type="checkbox"/> No Date ____
GRAVEL				240	285	12 Well head completion: <input checked="" type="checkbox"/> Pitless adapter <input checked="" type="checkbox"/> 18 Inches above grade
GRAY CLAY WITH GRAVEL				285	300	13 Well grouted? <input checked="" type="checkbox"/> Yes <input type="checkbox"/> No <input type="checkbox"/> Neat cement <input type="checkbox"/> Bentonite <input checked="" type="checkbox"/> CLAY Depth: From 0 ft. to 15 ft.
						14 Nearest source of possible contamination: SEPTIC ft. 200 Direction NORTH Type TANK Well disinfected upon completion? <input checked="" type="checkbox"/> Yes <input type="checkbox"/> No
						15 Pump: <input type="checkbox"/> Not installed Manufacturer's name FUNT AND WALLING Model number ____ HP 1 1/2 Volts 230 Length of drop pipe 240 ft. capacity 19 g.m.p. Type: <input checked="" type="checkbox"/> Submersible <input type="checkbox"/> Turbine <input type="checkbox"/> Jet <input type="checkbox"/> Reciprocating <input type="checkbox"/> Centrifugal <input type="checkbox"/> Other
16 Remarks: elevation Topography: <input type="checkbox"/> Hill <input checked="" type="checkbox"/> Slope <input type="checkbox"/> Upland <input type="checkbox"/> Valley				17 Water well contractor's certification: This well was drilled under my jurisdiction and this report is true to the best of my knowledge and belief. Pete Bartel 101 Business name Meade Plains License No. Box 707 Address Meade Plains Signed Pete Bartel Date 3-11-75 Authorized representative		