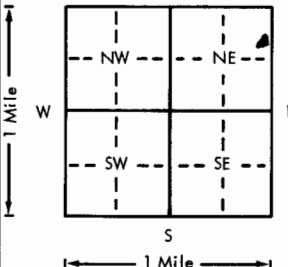
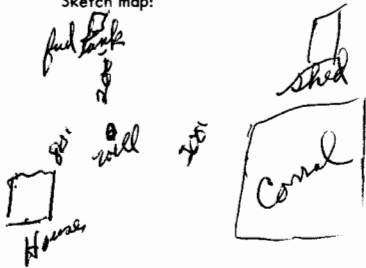


USE TYPEWRITER OR BALL
POINT PEN-PRESS FIRMLY,
PRINT CLEARLY.

WATER WELL RECORD
KSA 82a-1201-1215

Kansas Department of Health and
Environment-Division of Environment
(Water well Contractors)
Topeka, Kansas 66620

X Location of well:		County Meade	Fraction SW 1/4 NE 1/4 NE 1/4	Section number 7	Township number T 34 S	Range number R 30 E/W		
2. Distance and direction from nearest town or city: Plains, Kansas 9 S - Plains Street address of well location if in city:			3. Owner of well: Winton Bond R.R. or street: City, state, zip code: Plains, Kansas					
4. Locate with "X" in section below: 			Sketch map: 			6. Bore hole dia. 8 1/2 in. Completion date 4-19-78 Well depth 320 ft.		
5. Type and color of material			From	To	7. Cable tool <input checked="" type="checkbox"/> Rotary <input type="checkbox"/> Driven <input type="checkbox"/> Dug <input type="checkbox"/> Hollow rod <input type="checkbox"/> Jetted <input type="checkbox"/> Bored <input type="checkbox"/> Reverse rotary			
			Fine sand		0	20	8. Use: <input checked="" type="checkbox"/> Domestic <input type="checkbox"/> Public supply <input type="checkbox"/> Industry <input type="checkbox"/> Irrigation <input type="checkbox"/> Air conditioning <input type="checkbox"/> Stock <input type="checkbox"/> Lawn <input type="checkbox"/> Oil field water <input type="checkbox"/> Other	
			white clay		21	30	9. Casing: Material <input type="checkbox"/> Height: Above or below Threaded <input type="checkbox"/> Welded <input type="checkbox"/> Surface <input type="checkbox"/> in. RMP <input type="checkbox"/> PVC <input checked="" type="checkbox"/> Weight 200 lbs./ft. Dia. 5 in. to 320 ft. depth Wall Thickness: inches or Dia. <input type="checkbox"/> in. to <input type="checkbox"/> ft. depth gage No. <input type="checkbox"/>	
			blue clay		31	40	10. Screen: Manufacturer's name Jet Stream Type PVC Dia. 5 Slot/gauze 4" Length 40 Set between 280 ft. and 320 ft. Set between <input type="checkbox"/> ft. and <input type="checkbox"/> ft. Gravel pack? <input checked="" type="checkbox"/> Size range of material 1/4 - 3/8	
			medium sand		41	60	11. Static water level: <input type="checkbox"/> mo./day/yr. 197 ft. below land surface Date 4/19/78	
			sand + clay		61	90	12. Pumping level below land surfaces: 197 ft. after 1 1/2 hrs. pumping 25 g.p.m. <input type="checkbox"/> ft. after <input type="checkbox"/> hrs. pumping <input type="checkbox"/> g.p.m. Estimated maximum yield 50 g.p.m.	
			sand 1/2"		91	100	13. Water sample submitted: <input type="checkbox"/> mo./day/yr. <input type="checkbox"/> Yes <input checked="" type="checkbox"/> No Date <input type="checkbox"/>	
sand 1/8"		101	300	14. Well head completion: <input checked="" type="checkbox"/> Pitless adapter 18 inches above grade				
sand + clay		301	315	15. Well grouted? <input checked="" type="checkbox"/> With: <input type="checkbox"/> Neat cement <input type="checkbox"/> Bentonite <input checked="" type="checkbox"/> Concrete Depth: From 5 ft. to 15 ft.				
gravel		319	320	16. Nearest source of possible contamination: ft. 100 Direction S Type fuel Well disinfected upon completion? <input checked="" type="checkbox"/> Yes <input type="checkbox"/> No				
(Use a second sheet if needed)				17. Pump: Not installed Manufacturer's name Flint & Walling Model number 10BA15 HP 1 Volts 230 Length of drop pipe <input type="checkbox"/> ft. capacity <input type="checkbox"/> g.p.m. Type: <input checked="" type="checkbox"/> Submersible <input type="checkbox"/> Turbine <input type="checkbox"/> Jet <input type="checkbox"/> Reciprocating <input type="checkbox"/> Centrifugal <input type="checkbox"/> Other				
18. Elevation: Topography: <input type="checkbox"/> Hill <input type="checkbox"/> Slope <input checked="" type="checkbox"/> Upland <input type="checkbox"/> Valley	19. Remarks:		20. Water well contractor's certification: This well was drilled under my jurisdiction and this report is true to the best of my knowledge and belief. Bertil Drey 101A Business name Meade Kans License No. <input type="checkbox"/> Address Meade Kans Signed Bertil Drey Date 9-78 Authorized representative					

34 30 E 7 S
1/4 1/4 1/4