


1 LOCATION OF WATER WELL:		Fraction	Section Number	Township Number	Range Number
County:	MEADE	NE 1/4 NE 1/4 NE 1/4	18	T 34 S	R 30 E/W

Distance and direction from nearest town or city street address of well if located within city?

11 South & W 1 West of Plains, Kansas

2 WATER WELL OWNER:		XIT RANCH	(North Lane Pasture)
RR#, St. Address, Box # :		RFD	Board of Agriculture, Division of Water Resources
City, State, ZIP Code :		Plains, Ks. 67869	Application Number: ---

3 LOCATE WELL'S LOCATION WITH AN "X" IN SECTION BOX: 4 DEPTH OF COMPLETED WELL: 294 ft. ELEVATION: Upland

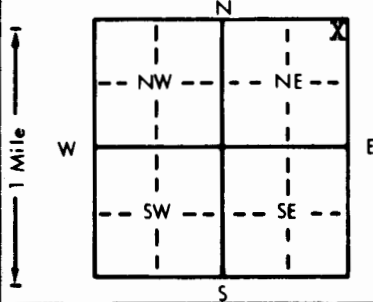

4 DEPTH OF COMPLETED WELL . . . 294 . . . ft. ELEVATION: . . . Upland . . .
 Depth(s) Groundwater Encountered 1. ~~Not available~~ 2. . . . ft. 3. . . . ft.
 WELL'S STATIC WATER LEVEL . . . 20 . . . ft. below land surface measured on mo/day/yr April 24, 1984 . . .
 Pump test data: Well water was . . . ft. after . . . hours pumping . . . gpm
 Est. Yield 20 . . . gpm; Well water was . . . ft. after . . . hours pumping . . . gpm
 Bore Hole Diameter 8 7/8 . . . in. to . . . 294 . . . ft., and . . . in. to . . . ft.
 WELL WATER TO BE USED AS: 5 Public water supply 8 Air conditioning 11 Injection well
 ⑥ Domestic 3 Feedlot 6 Oil field water supply 9 Dewatering XX2 Other (Specify below)
 2 Irrigation 4 Industrial 7 Lawn and garden only 10 Observation well . . . Stock . . .
 Was a chemical/bacteriological sample submitted to Department? Yes. ~~XXXX~~ No. . . . ; If yes, mo/day/yr sample was submitted
 Water Well Disinfected? Yes XX No

5	TYPE OF BLANK CASING USED:		5 Wrought iron	8 Concrete tile	CASING JOINTS: Glued . . XX . Clamped Welded Threaded
	1 Steel	3 RMP (SR)	6 Asbestos-Cement	9 Other (specify below)	
	XX PVC	4 ABS	7 Fiberglass		

Blank casing diameter 5 in. to 214 ft., Dia in. to ft., Dia in. to ft.
Casing height above land surface 24 in., weight 2.8 lbs./ft. Wall thickness or gauge No. .265

TYPE OF SCREEN OR PERFORATION MATERIAL:			XX PVC	10 Asbestos-cement
1 Steel	3 Stainless steel	5 Fiberglass	8 RMP (SR)	11 Other (specify)
2 Brass	4 Galvanized steel	6 Concrete tile	9 ABS	12 None used (open hole)

SCREEN OR PERFORATION OPENINGS ARE:		5 Gauzed wrapped	XX 8 Saw cut	11 None (open hole)
1 Continuous slot	3 Mill slot	6 Wire wrapped	9 Drilled holes	
2 Louvered shutter	4 Key punched	7 Torch cut	10 Other (specify)	

SCREEN-PERFORATED INTERVALS:	From 214 ft. to 294 ft.,	From ft. to ft.
	From ft. to ft.,	From ft. to ft.
GRAVEL PACK INTERVALS:	From 214 10 ft. to 294 ft.,	From ft. to ft.
	From ft. to ft.,	From ft. to ft.

6 GROUT MATERIAL: ☒ Neat cement 2 Cement grout 3 Bentonite 4 Other

Grout Intervals: From 0 ft. to 10 ft. From ft. to ft. From ft. to ft.

What is the nearest source of possible contamination:		NONE	10 Livestock pens	14 Abandoned water well
1 Septic tank	4 Lateral lines	7 Pit privy	11 Fuel storage	15 Oil well/Gas well
2 Sewer lines	5 Cess pool	8 Sewage lagoon	12 Fertilizer storage	16 Other (specify below)
3 Watertight sewer lines	6 Seepage pit	9 Feedyard	13 Insecticide storage

Direction from well? _____ How many feet? _____

[illegible]

7 CONTRACTOR'S OR LANDOWNER'S CERTIFICATION: This water well was (1) constructed, (2) reconstructed, or (3) plugged under my jurisdiction and was completed on (mo/day/year) April 26, 1984 and this record is true to the best of my knowledge and belief. Kansas Water Well Contractor's License No. 252 This Water Well Record was completed on (mo/day/yr) May 24, 1984 under the business name of Friesen Windmill & Supply Inc. by (signature) [Signature]

INSTRUCTIONS: Use typewriter or ball point pen, PLEASE PRESS FIRMLY and PRINT clearly. Please fill in blank underline or circle the correct answers. Send top three copies to Kansas Department of Health and Environment, Division of Environment, Environmental Geology Section, Topeka, KS 66620. Send one to WATER WELL OWNER and retain one for your records.