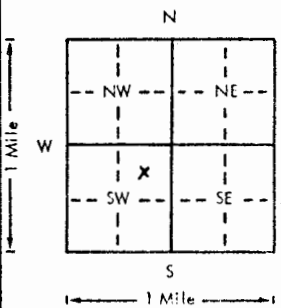


USE TYPEWRITER OR BALL
POINT PEN-PRESS FIRMLY,
PRINT CLEARLY.

WATER WELL RECORD
KSA 82a-1201-1215

Kansas Department of Health and
Environment-Division of Environment
(Water well Contractors)
Topeka, Kansas 66620

1. Location of well:		County <u>MEADE</u>	Fraction <u>Center</u> <u>1/4 NE 1/4 SW 1/4</u>	Section number <u>32</u>	Township number <u>T 34</u> <u>(S)</u>	Range number <u>R 30</u> <u>(E)</u>
2. Distance and direction from nearest town or city: <u>1 1/2 m S Plains & W 4 S</u> Street address of well location if in city:				3. Owner of well: <u>R. E. Adams</u> R.R. or street: <u>RR</u> City, state, zip code: <u>LIBERAL, KANSAS 67901</u>		
4. Locate with "X" in section below:		Sketch map:		6. Bore hole dia. <u>9</u> in. Completion date <u>4/14/81</u> Well depth <u>220</u> ft.		
				7. <input type="checkbox"/> Cable tool <input checked="" type="checkbox"/> Rotary <input type="checkbox"/> Driven <input type="checkbox"/> Dug <input type="checkbox"/> Hollow rod <input type="checkbox"/> Jetted <input type="checkbox"/> Bored <input type="checkbox"/> Reverse rotary		
5. Type and color of material				From	To	8. Use: <input type="checkbox"/> Domestic <input type="checkbox"/> Public supply <input type="checkbox"/> Industry <input type="checkbox"/> Irrigation <input type="checkbox"/> Air conditioning <input type="checkbox"/> Stock <input type="checkbox"/> Lawn <input checked="" type="checkbox"/> Oil field water <input type="checkbox"/> Other
<u>OVERBURDEN</u>				<u>0</u>	<u>85</u>	9. Casing: Material <u>PVC</u> Height: <u>Above</u> or below Threaded <input type="checkbox"/> Welded <input type="checkbox"/> Surface <u>14</u> in. RMP <input type="checkbox"/> PVC <u>14</u> in. Weight <u>14</u> lbs./ft. Dia. <u>5</u> in. to <u>140</u> ft. depth Wall Thickness: inches or Dia. <u>5</u> in. to <u>140</u> ft. depth gage No. <u>0258</u>
<u>MEDIUM SAND</u>				<u>85</u>	<u>145</u>	10. Screen: Manufacturer's name <u>LOPESTAR</u> Type <u>PVC</u> Dia. <u>5"</u> Slot/gauze <u>1/16</u> Length <u>100'</u> Set between <u>120</u> ft. and <u>220</u> ft. ft. and <u>1</u> ft.
<u>MEDIUM SAND & BLUE CLAY</u>				<u>145</u>	<u>185</u>	Gravel pack? <u>YES</u> Size range of material <u>1/8</u>
<u>MEDIUM TO COARSE SAND</u>				<u>185</u>	<u>220</u>	11. Static water level: <u>85</u> ft. below land surface. Date <u>4/14/81</u> mo./day/yr.
						12. Pumping level below land surfaces: ft. after <u> </u> hrs. pumping <u> </u> g.p.m. ft. after <u> </u> hrs. pumping <u> </u> g.p.m. Estimated maximum yield <u>75</u> g.p.m.
						13. Water sample submitted: <u> </u> mo./day/yr. Yes <input checked="" type="checkbox"/> No <input type="checkbox"/> Date <u> </u>
						14. Well head completion: <u> </u> Pitless adapter <u>14</u> inches above grade
						15. Well grouted? <u>YES</u> With: <input checked="" type="checkbox"/> Neat cement <input type="checkbox"/> Bentonite <input type="checkbox"/> Concrete Depth: From <u>3</u> ft. to <u>13</u> ft.
						16. Nearest source of possible contamination: <u>None</u> ft. <u> </u> Direction <u> </u> Type <u> </u> Well disinfected upon completion? <input checked="" type="checkbox"/> Yes <input type="checkbox"/> No
						17. Pump: <u> </u> Not installed Manufacturer's name <u>Pioneer</u> Model number <u>87037A</u> HP <u>7.5</u> Volts <u>230</u> Length of drop pipe <u>189</u> ft. capacity <u>60</u> g.p.m. Type: <input checked="" type="checkbox"/> Submersible <input type="checkbox"/> Turbine <input type="checkbox"/> Jet <input type="checkbox"/> Reciprocating <input type="checkbox"/> Centrifugal <input type="checkbox"/> Other
						20. Water well contractor's certification: This well was drilled under my jurisdiction and this report is true to the best of my knowledge and belief. <u>T.W. WATER WELL SERVICE</u> <u>142</u> Business Name <u>Box 816 Liberal KS 67901</u> License No. <u>67901</u> Address <u> </u> Date <u>4/30/81</u> Signed <u> </u> Authorized representative
18. Elevation:		19. Remarks:				
Topography: <input type="checkbox"/> Hill <input type="checkbox"/> Slope <input checked="" type="checkbox"/> Upland <input type="checkbox"/> Valley		<u>16. Well in field - no known source</u> <u>17. Pumped well 10 days pulled</u> <u>pump - capped well</u>				