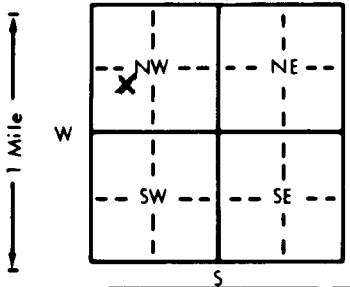


1 LOCATION OF WATER WELL:		Fraction	Section Number	Township Number	Range Number
County: Meade		N1 1/4 SW 1/4 NW 1/4	14	T 34 S	R 30 EW
Distance and direction from nearest town or city street address of well if located within city? 13 miles South, 1 mile west, 1/2 mile South of Plains					
2 WATER WELL OWNER: Charles Johnson Murfin Drilling, Inc.					
RR#, St. Address, Box # : Box 266		Box 661		Board of Agriculture, Division of Water Resources	
City, State, ZIP Code : Hugo, Co. 80821		Colby, Ks. 67701		Application Number: 950167	
3 LOCATE WELL'S LOCATION WITH AN "X" IN SECTION BOX:		4 DEPTH OF COMPLETED WELL: 300 ft. ELEVATION:			
		Depth(s) Groundwater Encountered 1 ft. 2. ft. 3. ft.			
		WELL'S STATIC WATER LEVEL 167 ft. below land surface measured on mo/day/yr			
		Pump test data: Well water was ft. after hours pumping gpm			
		Est. Yield gpm: Well water was ft. after hours pumping gpm			
		Bore Hole Diameter 8 in. to 300 ft., and in. to ft.			
WELL WATER TO BE USED AS:		5 Public water supply 8 Air conditioning 11 Injection well			
1 Domestic 3 Feedlot 6 Oil field water supply 9 Dewatering 12 Other (Specify below)					
2 Irrigation 4 Industrial 7 Lawn and garden only 10 Monitoring well					
Was a chemical/bacteriological sample submitted to Department? Yes No X ; If yes, mo/day/yr sample was submitted					
Water Well Disinfected? Yes No X					
5 TYPE OF BLANK CASING USED:					
1 Steel 3 RMP (SR) 6 Asbestos-Cement 9 Other (specify below)		5 Wrought iron 8 Concrete tile		CASING JOINTS: Glued X Clamped	
2 PVC 4 ABS 7 Fiberglass				Welded	
				Threaded	
Blank casing diameter 4.5 in. to 260 ft. Dia. in. to ft. Dia. in. to ft.					
Casing height above land surface 18 in., weight 2.38 lbs./ft. Wall thickness or gauge No. 248					
TYPE OF SCREEN OR PERFORATION MATERIAL:					
1 Steel 3 Stainless steel 5 Fiberglass 8 RMP (SR) 11 Other (specify)		7 PVC 10 Asbestos-cement			
2 Brass 4 Galvanized steel 6 Concrete tile 9 ABS 12 None used (open hole)					
SCREEN OR PERFORATION OPENINGS ARE:					
1 Continuous slot 3 Mill slot 5 Gauzed wrapped 8 Saw cut 11 None (open hole)		6 Wire wrapped 9 Drilled holes			
2 Louvered shutter 4 Key punched 7 Torch cut 10 Other (specify)					
SCREEN-PERFORATED INTERVALS: From 260 ft. to 300 ft. From ft. to ft.					
GRAVEL PACK INTERVALS: From 20 ft. to 300 ft. From ft. to ft.					
6 GROUT MATERIAL: 1 Neat cement 2 Cement grout 3 Bentonite 4 Other					
Grout intervals: From 0 ft. to 20 ft. From ft. to ft. From ft. to ft.					
What is the nearest source of possible contamination:					
1 Septic tank 4 Lateral lines 7 Pit privy 10 Livestock pens 14 Abandoned water well		11 Fuel storage 15 Oil well/Gas well			
2 Sewer lines 5 Cess pool 8 Sewage lagoon 12 Fertilizer storage 16 Other (specify below)					
3 Watertight sewer lines 6 Seepage pit 9 Feedyard 13 Insecticide storage					
Direction from well? West		How many feet? 150'			
FROM	TO	LITHOLOGIC LOG	FROM	TO	PLUGGING INTERVALS
0	10	Fine Sand	171	200	Fine to Med. Sand w/Clay Str.
10	43	Clay w/Caliche	200	280	Med. Sand w/a few Clay Strks.
43	90	Caliche & Sandy Clay	280	297	Med. Sand
90	99.5	Med. Sand & Gravel	297	300	Shale
99.5	104	Cemented Sand			
104	109	Med. Sand & Gravel			
109	109.5	Cemented Sand			
109.5	130	Med. Sand			
130	135	Cemented Sand w/a few Clay lyrs.			
135	146	Med. Sand & Gravel w/ a few Clay strks.			
146	147	Cemented Sand			
147	157	Med. Sand & Gravel			
157	158.5	Cemented Sand & Caliche			
158.5	165	Med. Sand			
165	171	Sandy Clay & Caliche w/some Sand			
7 CONTRACTOR'S OR LANDOWNER'S CERTIFICATION: This water well was (1) constructed, (2) reconstructed, or (3) plugged under my jurisdiction and was completed on (mo/day/year) 6-6-95 and this record is true to the best of my knowledge and belief. Kansas Water Well Contractor's License No. 554 This Water Well Record was completed on (mo/day/yr) 6-7-95 under the business name of Woofert Pump & Well, Inc. by (signature) <i>[Signature]</i>					
INSTRUCTIONS: Use typewriter or ball point pen. PLEASE PRESS FIRMLY and PRINT clearly. Please fill in blanks, underline or circle the correct answers. Send top three copies to Kansas Department of Health and Environment, Bureau of Water, Topeka, Kansas 66620-0001. Telephone: 913-296-5545. Send one to WATER WELL OWNER and retain one for your records.					