


1] LOCATION OF WATER WELL: County: Seward Fraction: NE 1/4 Section Number: 5 Township Number: T 34 S Range Number: R 31 E/W

Distance and direction from nearest town or city street address of well if located within city?

2] WATER WELL OWNER: Anadarko Pet. #1 McClure 'H' RR#, St. Address, Box #: P.O. Box 351 Board of Agriculture, Division of Water Resources City, State, ZIP Code: Liberal, Ks 67905 Application Number: 970167

3] LOCATE WELL'S LOCATION WITH AN 'X' IN SECTION BOX: 4] DEPTH OF COMPLETED WELL: 200 ft. ELEVATION:

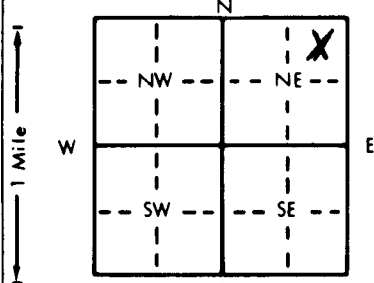

Depth(s) Groundwater Encountered: 1. 65 ft. 2. ft. 3. ft. WELL'S STATIC WATER LEVEL: 65 ft. below land surface measured on mo/day/yr: 3-25-97 Pump test data: Well water was 147 ft. after 1 hours pumping 110 gpm Est. Yield: 110 gpm Well water was ft. after hours pumping gpm Bore Hole Diameter: 11 in. to ft. and in. to ft. WELL WATER TO BE USED AS: 5 Public water supply 8 Air conditioning 11 Injection well 1 Domestic 3 Feedlot 6 Oil field water supply 9 Dewatering 12 Other (Specify below) 2 Irrigation 4 Industrial 7 Lawn and garden only 10 Monitoring well Was a chemical/bacteriological sample submitted to Department? Yes No X If yes, mo/day/yr sample was submitted Water Well Disinfected? Yes X No

5] TYPE OF BLANK CASING USED: 1 Steel 3 RMP (SR) 5 Wrought iron 8 Concrete tile CASING JOINTS: Glued X Clamped 2 PVC 4 ABS 7 Fiberglass 9 Other (specify below) Welded Threaded

Blank casing diameter: 11 in. to 200 ft. Dia. in. to ft. Dia. in. to ft. Casing height above land surface: 24 in. weight: 2,902 lbs./ft. Wall thickness or gauge No. 281 SDR 21

TYPE OF SCREEN OR PERFORATION MATERIAL: 1 Steel 3 Stainless steel 5 Fiberglass 8 RMP (SR) 10 Asbestos-cement 2 Brass 4 Galvanized steel 6 Concrete tile 9 ABS 11 Other (specify) 12 None used (open hole)

SCREEN OR PERFORATION OPENINGS ARE: 1 Continuous slot 3 Mill slot 5 Gauzed wrapped 8 Saw cut 11 None (open hole) 2 Louvered shutter 4 Key punched 6 Wire wrapped 9 Drilled holes 7 Torch cut 10 Other (specify)

SCREEN-PERFORATED INTERVALS: From 120 ft. to 200 ft. GRAVEL PACK INTERVALS: From 20 ft. to 200 ft.

6] GROUT MATERIAL: 1 Neat cement 2 Cement grout 3 Bentonite 4 Other Hole Plug Grout Intervals: From 0 ft. to 20 ft. From ft. to ft. From ft. to ft.

What is the nearest source of possible contamination: 1 Septic tank 4 Lateral lines 7 Pit privy 10 Livestock pens 14 Abandoned water well 2 Sewer lines 5 Cess pool 8 Sewage lagoon 11 Fuel storage 15 Oil well/Gas well 3 Watertight sewer lines 6 Seepage pit 9 Feedyard 12 Fertilizer storage 16 Other (specify below) 13 Insecticide storage

Direction from well? West How many feet? 140

Table with columns: FROM, TO, LITHOLOGIC LOG, FROM, TO, PLUGGING INTERVALS. Rows: 0-2 Surface, 2-6 Clay, 6-18 Sandy Clay, 18-200 Sand & Gravel.

7] CONTRACTOR'S OR LANDOWNER'S CERTIFICATION: This water well was (1) constructed, (2) reconstructed, or (3) plugged under my jurisdiction and was completed on (mo/day/year) 3-25-97 and this record is true to the best of my knowledge and belief. Kansas Water Well Contractor's License No. KWCL - 430 This Water Well Record was completed on (mo/day/yr) 3-25-97 under the business name of Howard Drlg. Box 806 Beaver, Ok 73932 by (signature)