


1 LOCATION OF WATER WELL: County: Seward	Fraction W2 1/4 NE 1/4 NE 1/4	Section Number 8	Township Number T 34 S	Range Number R 31 EW
--	---	----------------------------	----------------------------------	--------------------------------

Distance and direction from nearest town or city street address of well if located within city? **Approx 11mi., NE. of Liberal on #54, to Road Side Park on N., Side of Road, on S., Side go Thur C.G., 3.5 mi., to Loc.**

2 WATER WELL OWNER: **Anadarko Pet** #1 Davies "F"
 RR#, St. Address, Box #: **Box 351** Board of Agriculture, Division of Water Resources
 City, State, ZIP Code: **Liberal, Ks. 67905** Application Number: **960281**

3 LOCATE WELL'S LOCATION WITH AN "X" IN SECTION BOX:

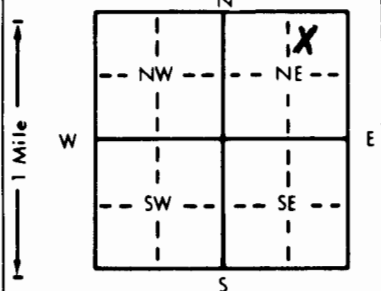

4 DEPTH OF COMPLETED WELL: **140** ft. ELEVATION:
 Depth(s) Groundwater Encountered 1. **15** ft. 2. _____ ft. 3. _____ ft.
 WELL'S STATIC WATER LEVEL: **15** ft. below land surface measured on mo/day/yr **8-7-96**
 Pump test data: Well water was **.50** ft. after **1** hours pumping **100** gpm
 Est. Yield **100** gpm: Well water was _____ ft. after _____ hours pumping _____ gpm
 Bore Hole Diameter **11** in. to **140** ft., and _____ in. to _____ ft.

WELL WATER TO BE USED AS:
 5 Public water supply 8 Air conditioning 11 Injection well
 1 Domestic 3 Feedlot **6** Oil field water supply 9 Dewatering 12 Other (Specify below)
 2 Irrigation 4 Industrial 7 Lawn and garden only 10 Monitoring well
 Was a chemical/bacteriological sample submitted to Department? Yes _____ No **X**; If yes, mo/day/yr sample was submitted _____
 Water Well Disinfected? Yes **X** No _____

5 TYPE OF BLANK CASING USED:
 1 Steel 3 RMP (SR) 5 Wrought iron 8 Concrete tile CASING JOINTS: Glued **X** Clamped _____
2 PVC 4 ABS 7 Fiberglass _____ Threaded _____
 Blank casing diameter **6** in. to **140** ft., Dia _____ in. to _____ ft., Dia _____ in. to _____ ft.
 Casing height above land surface **24** in., weight **2,902** lbs./ft. Wall thickness or gauge No. **280** SDR **21**

TYPE OF SCREEN OR PERFORATION MATERIAL:
 1 Steel 3 Stainless steel 5 Fiberglass **7** PVC 10 Asbestos-cement
 2 Brass 4 Galvanized steel 6 Concrete tile 8 RMP (SR) 11 Other (specify) _____
 12 None used (open hole)

SCREEN OR PERFORATION OPENINGS ARE:
 1 Continuous slot 3 Mill slot 5 Gauzed wrapped **8** Saw cut 11 None (open hole)
 2 Louvered shutter 4 Key punched 6 Wire wrapped 9 Drilled holes
 7 Torch cut 10 Other (specify) _____

SCREEN-PERFORATED INTERVALS: From **100** ft. to **140** ft., From _____ ft. to _____ ft.
 From _____ ft. to _____ ft., From _____ ft. to _____ ft.

GRAVEL PACK INTERVALS: From **40** ft. to **140** ft., From _____ ft. to _____ ft.
 From _____ ft. to _____ ft., From _____ ft. to _____ ft.

6 GROUT MATERIAL: **1** Neat cement 2 Cement grout 3 Bentonite **4** Other **Hole Plug**
 Grout Intervals: From **0** ft. to **16** ft., From _____ ft. to _____ ft.

What is the nearest source of possible contamination:
 1 Septic tank 4 Lateral lines 7 Pit privy 10 Livestock pens 14 Abandoned water well
 2 Sewer lines 5 Cess pool 8 Sewage lagoon 11 Fuel storage **15** Oil well/Gas well
 3 Watertight sewer lines 6 Seepage pit 9 Feedyard 12 Fertilizer storage 16 Other (specify below)
 13 Insecticide storage

Direction from well? **Southeast** How many feet? **235**

FROM	TO	LITHOLOGIC LOG	FROM	TO	PLUGGING INTERVALS
0	8	Fine Sand			
8	11	Blue Clay			
11	25	Coarse Sand			
25	28	Tan Clay			
28	116	Sand			
116	133	Sand W/ Red Streaks			
133	140	Red Clay / Blue Clay / Blue Shale			

7 CONTRACTOR'S OR LANDOWNER'S CERTIFICATION: This water well was **(1)** constructed, (2) reconstructed, or (3) plugged under my jurisdiction and was completed on (mo/day/year) **8-07-96** and this record is true to the best of my knowledge and belief. Kansas Water Well Contractor's License No. **KWWCL - 430** This Water Well Record was completed on (mo/day/yr) **8-07-96** under the business name of **Howard Drlg, Box 806, Beaver, OK. 73932** by (signature) *[Signature]*