


1 LOCATION OF WATER WELL: Fraction NE 1/4 NE 1/4 NE 1/4 Section Number 29 Township Number T 34 S Range Number R 31 E/W
 County: Seward

Distance and direction from nearest town or city street address of well if located within city?
Liberal; E on Blue Bell 11 miles, 1.6N., & N into

2 WATER WELL OWNER: Seaboard Farms Handy
 RR#, St. Address, Box #: P.O. Box 1207 Board of Agriculture, Division of Water Resources
 City, State, ZIP Code: Guyton, Ok 73942 Application Number:

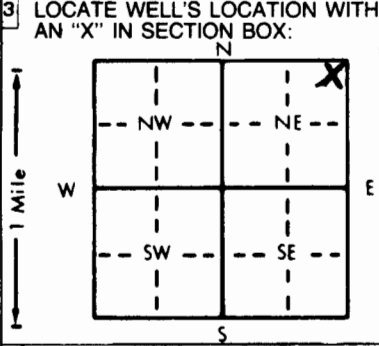

4 DEPTH OF COMPLETED WELL: 420 ft. ELEVATION:
 Depth(s) Groundwater Encountered 1. 210 ft. 2. ft. 3. ft.
 WELL'S STATIC WATER LEVEL 210 ft. below land surface measured on mo/day/yr 7-11-97
 Pump test data: Well water was 357 ft. after 1 hours pumping 90 gpm
 Est. Yield 90 gpm: Well water was ft. after hours pumping gpm
 Bore Hole Diameter: 11 in. to 420 ft., and in. to ft.
 WELL WATER TO BE USED AS: 5 Public water supply 8 Air conditioning 11 Injection well
 1 Domestic 3 Feedlot 6 Oil field water supply 9 Dewatering 12 Other (Specify below)
 2 Irrigation 4 Industrial 7 Lawn and garden only 10 Monitoring well Hog farm
 Was a chemical/bacteriological sample submitted to Department? Yes.....No.....X.....; If yes, mo/day/yr sample was submitted
 Water Well Disinfected? Yes X No

5 TYPE OF BLANK CASING USED: 5 Wrought iron 8 Concrete tile CASING JOINTS: Glued X Clamped
 1 Steel 3 RMP (SR) 6 Asbestos-Cement 9 Other (specify below) Welded
2 PVC 4 ABS 7 Fiberglass Threaded.....
 Blank casing diameter 6 in. to 420 ft., Dia in. to ft., Dia in. to ft.
 Casing height above land surface: 24 in., weight 2.902 lbs./ft. Wall thickness or gauge No. .281 Sdr 21
 TYPE OF SCREEN OR PERFORATION MATERIAL: 7 PVC 10 Asbestos-cement
 1 Steel 3 Stainless steel 5 Fiberglass 8 RMP (SR) 11 Other (specify)
 2 Brass 4 Galvanized steel 6 Concrete tile 9 ABS 12 None used (open hole)
 SCREEN OR PERFORATION OPENINGS ARE: 5 Gauzed wrapped 8 Saw cut 11 None (open hole)
 1 Continuous slot 3 Mill slot 6 Wire wrapped 9 Drilled holes
 2 Louvered shutter 4 Key punched 7 Torch cut 10 Other (specify)
 SCREEN-PERFORATED INTERVALS: From 280 ft. to 420 ft., From ft. to ft.
 From ft. to ft., From ft. to ft.
 GRAVEL PACK INTERVALS: From 200 ft. to 420 ft., From ft. to ft.
 From ft. to ft., From ft. to ft.

6 GROUT MATERIAL: 1 Neat cement 2 Cement grout 3 Bentonite 4 Other Hole Plug
 Grout Intervals: From 0 ft. to 20 ft., From ft. to ft., From ft. to ft.
 What is the nearest source of possible contamination:
 1 Septic tank 4 Lateral lines 7 Pit privy 10 Livestock pens 14 Abandoned water well
 2 Sewer lines 5 Cess pool 8 Sewage lagoon 11 Fuel storage 15 Oil well/Gas well
 3 Watertight sewer lines 6 Seepage pit 9 Feedyard 12 Fertilizer storage 16 Other (specify below)
 13 Insecticide storage

Direction from well? How many feet?

FROM	TO	LITHOLOGIC LOG	FROM	TO	PLUGGING INTERVALS
0	2	Sandy Clay / Top	311	330	Sandy Clay / Sand
2	8	Sandy Clay	330	340	Caliche / Clay
8	51	Caliche / Clay	340	360	Sandy Clay
51	60	Caliche / Sandy Clay	360	400	Clay / Sandy Clay
60	65	Sand	400	420	Clay / Blue Clay
65	68	Caliche / Rock			
68	86	Caliche / Clay			
86	129	Sand			
129	147	Caliche / Clay			
147	160	Sand / Sandy Clay			
160	176	Clay / Sandy Clay			
176	200	Sand W/Clay Streaks			
200	282	Sand			
282	302	Sand W/Clay Streaks			
302	311	Sand Caliche			

7 CONTRACTOR'S OR LANDOWNER'S CERTIFICATION: This water well was (1) constructed, (2) reconstructed, or (3) plugged under my jurisdiction and was completed on (mo/day/year) 7-11-97 and this record is true to the best of my knowledge and belief. Kansas Water Well Contractor's License No. KWCL -430 This Water Well Record was completed on (mo/day/yr) 7-11-97 under the business name of Howard Drlg. Box 806 Beaver, Ok 73932 by (signature) [Signature]

INSTRUCTIONS: Use typewriter or ball point pen. PLEASE PRESS FIRMLY and PRINT clearly. Please fill in blanks, underline or circle the correct answers. Send top three copies to Kansas Department of Health and Environment, Bureau of Water, Topeka, Kansas 66620-0001. Telephone: 913-296-5545. Send one to WATER WELL OWNER and retain one for your records.