USE TYPEWRITER OR BALL POINT PEN-PRESS FIRMLY, PRINT CLEARLY.

T	R	EW	sec 1/4	1/4	1/4 No.

WATER WELL RECORD
KSA 82a-1201-1215

Kansas State Dept. Of Health
(Water Well Contractors)
Forbes-Bldg. 740
Topeka, Kansas 66620

Keating #1 CWW Inv. # 11372

1 Location of well: County	Township name	Fraction	Section number	Town number	Range number
Seward		NW NW	14	34S	31W

Distance and direction from nearest town or city: 14 miles east of Liberal, 5 south, 1 east.
Street address of well location if in city:

3 Owner of well: Unit Drilling Company Rig #1
Address: 1101 Petroleum Club Bldg. Tulsa, Oklahoma 74119

Locate with "X" in section below: Sketch map:

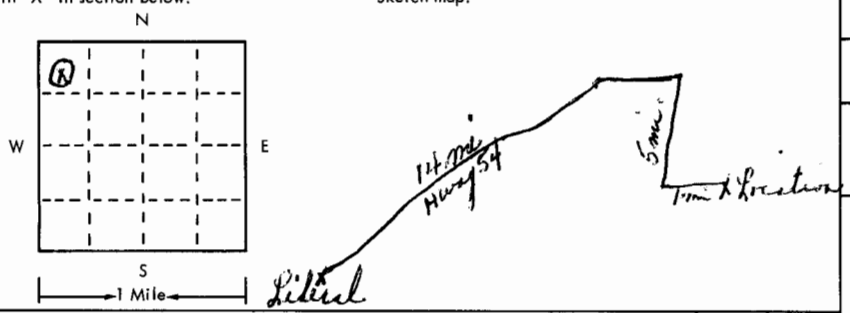

4 Well depth: 200 ft. Date of completion 6-3-75
Well diameter 9 in.

5 ☐ Cable tool ☒ Rotary ☐ Driven ☐ Dug
☐ Hollow rod ☐ Jetted ☐ Bored ☐ Reverse rotary

6 Use: ☐ Domestic ☐ Public supply ☒ Industry
☐ Irrigation ☐ Air conditioning ☐ Commercial
☐ Test well ☐ Oil Rig

7 Casing: Material PVC Height: above/below
Threaded ☐ Welded ☐ Surface 24 in.
Diam. Weight 2.78 lbs./ft.
5 in. to 130 ft. depth Drive shoe? ☐ Yes ☒ No
5 in. to 200 ft. depth

2

Type and color of material	From	To
Surface	0	2
Fine Sand	2	18
Clay	18	51
Fine Sand	51	97
97-116 Sandy clay	97	116
Coarse sand	116	190
Blue Clay	190	200
(use a second sheet if needed)		

8 Screen:
Manufacturer Wesco
Type PVC Dia. 5
Slot/gauze .030 Length 10
Set between 130 ft. and 140 ft.
Fittings: 1/8 - 3/16
Gravel pack ☒ Yes ☐ No Size range of material

9 Static water level:
98 ft. below land surface Date 6-3-75

10 Pumping level below land surfaces:
ft. after hrs. pumping g.p.m.
ft. after hrs. pumping g.p.m.
Estimated maximum yield 60 g.p.m.

11 Water sample submitted:
☐ Yes ☒ No Date

12 Well head completion:
☐ Pitless adapter 24 Inches above grade

13 Well grouted? ☒ Yes ☐ No
☒ Neat cement ☐ Bentonite ☐
Depth: From 0 ft. to 10 ft.

14 Nearest source of possible contamination:
ft. 100 Direction NE Type OilWell
Well disinfected upon completion? ☒ Yes ☐ No

15 Pump: ☒ Not installed
Manufacturer's name
Model number HP Volts
Length of drop pipe ft. capacity g.m.p.
Type:
☐ Submersible ☐ Turbine
☐ Jet ☐ Reciprocating
☐ Certrifugal ☐ Other

16 Remarks: elevation

Topography:
☐ Hill
☐ Slope
☒ Upland
☐ Valley

17 Water well contractor's certification:
This well was drilled under my jurisdiction and this report is true to the best of my knowledge and belief.
Business name Carlile Water Well License No. 118
Address Box 275, Liberal, Ks.
Signed Edward E. Means Date 6-13-75
Authorized representative

Forward the white, blue and pink copies to the Kansas State Dept. Of Health.

Form WWC-5

677-H