


1 LOCATION OF WATER WELL: County: SEWARD	Fraction C 1/4 SW 1/4 SW 1/4	Section Number 33	Township Number T 34S S	Range Number R 31W EW
---	---------------------------------	----------------------	----------------------------	--------------------------

Distance and direction from nearest town or city street address of well if located within city?
7 MILES SOUTHEAST FROM HAYES, KS.

2 WATER WELL OWNER: ZENITH DRILLING #1 LONG
 RR#, St. Address, Box # : BOX 2766 Board of Agriculture, Division of Water Resources
 City, State, ZIP Code : LIBERAL, KS 67905-2766 Application Number: #930507

3 LOCATE WELL'S LOCATION WITH AN "X" IN SECTION BOX:

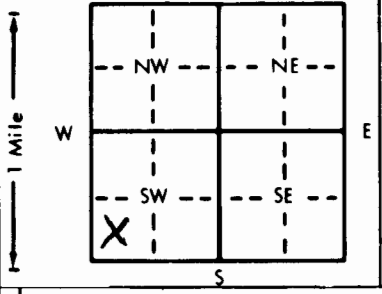

4 DEPTH OF COMPLETED WELL: 280 ft. ELEVATION: ...
 Depth(s) Groundwater Encountered 1. 200 ft. 2. ft. 3. ft.
 WELL'S STATIC WATER LEVEL . . . 200 . . . ft. below land surface measured on mo/day/yr .12-9-93
 Pump test data: Well water was . . 220 . . . ft. after . . . 1 hours pumping . . 80 gpm
 Est. Yield . . 80 . . . gpm: Well water was ft. after hours pumping gpm
 Bore Hole Diameter . . . 9 1/2 . . . in. to . . 280 ft., and in. to ft.
 WELL WATER TO BE USED AS: 5 Public water supply 8 Air conditioning 11 Injection well
 1 Domestic 3 Feedlot 6 Oil field water supply 9 Dewatering 12 Other (Specify below)
 2 Irrigation 4 Industrial 7 Lawn and garden only 10 Monitoring well
 Was a chemical/bacteriological sample submitted to Department? Yes No;; If yes, mo/day/yr sample was sub-
 mitted Water Well Disinfected? Yes x No

5 TYPE OF BLANK CASING USED: 5 Wrought iron 8 Concrete tile CASING JOINTS: Glued x Clamped
 1 Steel 3 RMP (SR) 6 Asbestos-Cement 9 Other (specify below) Welded
 2 PVC 4 ABS 7 Fiberglass Threaded
 Blank casing diameter . . . 5 . . . in. to . . . 280 . . . ft., Dia in. to ft., Dia in. to ft.
 Casing height above land surface . . 24 in., weight 2.902 lbs./ft. Wall thickness or gauge No. .280. SDR 21

TYPE OF SCREEN OR PERFORATION MATERIAL: 7 PVC 10 Asbestos-cement
 1 Steel 3 Stainless steel 5 Fiberglass 8 RMP (SR) 11 Other (specify)
 2 Brass 4 Galvanized steel 6 Concrete tile 9 ABS 12 None used (open hole)

SCREEN OR PERFORATION OPENINGS ARE: 5 Gauzed wrapped 8 Saw cut 11 None (open hole)
 1 Continuous slot 3 Mill slot 6 Wire wrapped 9 Drilled holes
 2 Louvered shutter 4 Key punched 7 Torch cut 10 Other (specify)

SCREEN-PERFORATED INTERVALS: From . . . 220 . . . ft. to . . 280 ft., From ft. to ft.
 From ft. to ft., From ft. to ft.
 GRAVEL PACK INTERVALS: From . . . 170 . . . ft. to 280 ft., From ft. to ft.
 From ft. to ft., From ft. to ft.

6 GROUT MATERIAL: 1 Neat cement 2 Cement grout 3 Bentonite 4 Other HOLE PLUG
 Grout Intervals: From . . . 1 . . . ft. to . . 20 ft., From ft. to ft., From ft. to ft.

What is the nearest source of possible contamination:
 1 Septic tank 4 Lateral lines 7 Pit privy 10 Livestock pens 14 Abandoned water well
 2 Sewer lines 5 Cess pool 8 Sewage lagoon 11 Fuel storage 15 Oil well/Gas well
 3 Watertight sewer lines 6 Seepage pit 9 Feedyard 12 Fertilizer storage 16 Other (specify below)
 13 Insecticide storage
 Direction from well? SOUTHEAST How many feet? 125'

FROM	TO	LITHOLOGIC LOG	FROM	TO	PLUGGING INTERVALS
0	10	FINE SAND			
10	30	CALICHE			
30	60	SANDY CLAY			
60	87	MED. TO COARSE SAND			
87	89	SAND STONE			
89	120	FINE TO COARSE SAND			
120	130	SANDY CLAY			
130	198	FINE TO COARSE SAND & GRAVEL			
198	205	SANDY BLUE CLAY			
205	270	FINE TO COARSE SAND STREAKS OF CLAY AT 225-230			
270	280	BLUE & BROWN CLAY			

7 CONTRACTOR'S OR LANDOWNER'S CERTIFICATION: This water well was (1) constructed, (2) reconstructed, or (3) plugged under my jurisdiction and was completed on (mo/day/year) 12-9-93 and this record is true to the best of my knowledge and belief. Kansas Water Well Contractor's License No. KWWCL-430 This Water Well Record was completed on (mo/day/yr) 12-9-93 under the business name of HOWARD DRLG.CO.BOX 806 BEAVER, OK 73932 by (signature)

INSTRUCTIONS: Use typewriter or ball point pen. PLEASE PRESS FIRMLY and PRINT clearly. Please fill in blanks, underline or circle the correct answers. Send top three copies to Kansas Department of Health and Environment, Bureau of Water, Topeka, Kansas 66620-0001. Telephone: 913-296-5545. Send one to WATER WELL OWNER and retain one for your records.