


USE TYPEWRITER OR BALL POINT PEN-PRESS FIRMLY, PRINT CLEARLY.

WATER WELL RECORD
KSA 82a-1201-1215

Kansas Department of Health and Environment-Division of Environment
(Water well Contractors)
Topeka, Kansas 66620

1. Location of well: County Seward Fraction SW 1/4 NW 1/4 SW 1/4 Section number 35 Township number T 34 S R 31 E/W Range number 31

2. Distance and direction from nearest town or city: 17 miles E. of Liberal
Street address of well location if in city:
3. Owner of well: Max Louderbaak
R.R. or street: RFD #2
City, state, zip code: Liberal, Kansas 67901

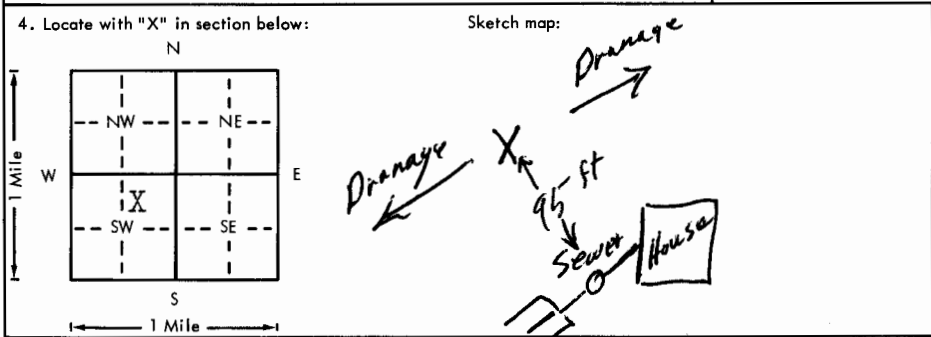

6. Bore hole dia. 9 in. Completion date 1-10-80
Well depth 280 ft.

7. Cable tool Rotary Driven Dug
 Hollow rod Jetted Bored Reverse rotary

8. Use: Domestic Public supply Industry
 Irrigation Air conditioning Stock
 Lawn Oil field water Other

9. Casing: Material PVC Height: Above or below
Threaded Welded Surface 24 in.
RMP PVC Weight lbs./ft.
Dia. 5 in. to 280 ft. depth | Wall Thickness: inches or
Dia. in. to ft. depth | gage No. 280

5. Type and color of material	From	To
Fine Sand & Silt	0	16
White Clay	16	32
Light Clay	32	41
Course Sand & Gravel	41	60
Light Clay	60	87
Limestone	87	94
Light Clay & Fine Sand Stra.	94	119
Sandstone & Clay Stra.	119	195
Gold clored Clay	195	202
Sand & Clay Stra.	202	280

10. Screen: Manufacturer's name Pump Co
Hand Slotted Casing
Type PVC Dia. 5"
Slot 1/8 x 4" Length 40'
Set between 240 ft. and 280 ft.
 ft. and ft.
Gravel pack? Yes Size range of material 1/8-1/4 ft.

11. Static water level: 210 ft. below land surface Date 1-10-80 mo./day/yr.

12. Pumping level below land surfaces: N/A
 ft. after hrs. pumping g.p.m.
 ft. after hrs. pumping g.p.m.
Estimated maximum yield 25 g.p.m.

13. Water sample submitted: mo./day/yr.
Yes No Date

14. Well head completion:
 Pitless adapter Inches above grade

15. Well grouted? Yes
With: Neat cement Bentonite Concrete
Depth: From 4 ft. to 14 ft.

16. Nearest source of possible contamination:
ft. 95' Direction S Type Sewer
Well disinfected upon completion? Yes No

17. Pump: Not installed
Manufacturer's name Goulds
Model number 10EJ HP 1 Volts 230
Length of drop pipe 270 ft. capacity 8 g.p.m.
Type:
 Submersible Turbine
 Jet Reciprocating
 Centrifugal Other

18. Elevation:
Topography:
 Hill
 Slope
 Upland
 Valley

19. Remarks:

20. Water well contractor's certification:
This well was drilled under my jurisdiction and this report is true to the best of my knowledge and belief.
Combs Engineering 342
Business name License No.
Address PO Box 39 Turpin Ok.
Signed Neal Combs Date 1-10-80
Authorized representative

34 310 35 SW 1/4 NW 1/4