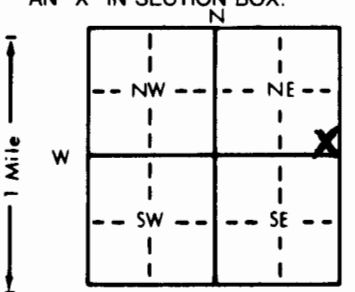


1 LOCATION OF WATER WELL: Fraction SE 1/4 SE 1/4 NE 1/4 Section Number 17 Township Number T 34S S Range Number R 32W EW  
 County: SEWARD

Distance and direction from nearest town or city street address of well if located within city?  
FROM LIBERAL EAST ON BLUE BELL RD TO ARKALON RD., 1 3/4 NORTHWEST S.E. OF WEGHT STATION.

2 WATER WELL OWNER: ABE FRIESEN  
 RR#, St. Address, Box # : BOX 152 Board of Agriculture, Division of Water Resources  
 City, State, ZIP Code : KISMET, KS 67859 Application Number:

3 LOCATE WELL'S LOCATION WITH AN "X" IN SECTION BOX:  
  
 4 DEPTH OF COMPLETED WELL: 300 ft. ELEVATION:  
 Depth(s) Groundwater Encountered 1. 220 ft. 2. \_\_\_\_\_ ft. 3. \_\_\_\_\_ ft.  
 WELL'S STATIC WATER LEVEL 220 ft. below land surface measured on mo/day/yr 03-15-96  
 Pump test data: Well water was 240 ft. after 1 hours pumping 70 gpm  
 Est. Yield 70 gpm: Well water was \_\_\_\_\_ ft. after \_\_\_\_\_ hours pumping \_\_\_\_\_ gpm  
 Bore Hole Diameter 9 1/2 in. to 300 ft., and \_\_\_\_\_ in. to \_\_\_\_\_ ft.  
 WELL WATER TO BE USED AS:  
 1 Domestic  3 Feedlot  Oil field water supply  9 Dewatering  12 Other (Specify below)  
 2 Irrigation  4 Industrial  Lawn and garden only  10 Monitoring well  
 Was a chemical/bacteriological sample submitted to Department? Yes \_\_\_\_\_ No  X; If yes, mo/day/yr sample was submitted \_\_\_\_\_  
 Water Well Disinfected? Yes  X No \_\_\_\_\_

5 TYPE OF BLANK CASING USED:  
 1 Steel  3 RMP (SR)  5 Wrought iron  8 Concrete tile CASING JOINTS: Glued  X Clamped \_\_\_\_\_  
 2 PVC  4 ABS  6 Asbestos-Cement  9 Other (specify below) Welded \_\_\_\_\_  
 7 Fiberglass \_\_\_\_\_ Threaded \_\_\_\_\_  
 Blank casing diameter 5 in. to 300 ft., Dia \_\_\_\_\_ in. to \_\_\_\_\_ ft., Dia \_\_\_\_\_ in. to \_\_\_\_\_ ft.  
 Casing height above land surface 24 in., weight 2.902 lbs./ft. Wall thickness or gauge No. 280 SDR 21  
 TYPE OF SCREEN OR PERFORATION MATERIAL:  
 1 Steel  3 Stainless steel  5 Fiberglass  7 PVC  10 Asbestos-cement  
 2 Brass  4 Galvanized steel  6 Concrete tile  9 ABS  11 Other (specify) \_\_\_\_\_  
 12 None used (open hole)  
 SCREEN OR PERFORATION OPENINGS ARE:  
 1 Continuous slot  3 Mill slot  5 Gauzed wrapped  8 Saw cut  11 None (open hole)  
 2 Louvered shutter  4 Key punched  6 Wire wrapped  9 Drilled holes  
 7 Torch cut  10 Other (specify) \_\_\_\_\_  
 SCREEN-PERFORATED INTERVALS: From 240 ft. to 300 ft., From \_\_\_\_\_ ft. to \_\_\_\_\_ ft.  
 From \_\_\_\_\_ ft. to \_\_\_\_\_ ft., From \_\_\_\_\_ ft. to \_\_\_\_\_ ft.  
 GRAVEL PACK INTERVALS: From 140 ft. to 300 ft., From \_\_\_\_\_ ft. to \_\_\_\_\_ ft.  
 From \_\_\_\_\_ ft. to \_\_\_\_\_ ft., From \_\_\_\_\_ ft. to \_\_\_\_\_ ft.

6 GROUT MATERIAL:  1 Neat cement  2 Cement grout  3 Bentonite  4 Other HOLE PLUG  
 Grout Intervals: From 0 ft. to 16 ft., From \_\_\_\_\_ ft. to \_\_\_\_\_ ft., From \_\_\_\_\_ ft. to \_\_\_\_\_ ft.  
 What is the nearest source of possible contamination:  
 1 Septic tank  4 Lateral lines  7 Pit privy  10 Livestock pens  14 Abandoned water well  
 2 Sewer lines  5 Cess pool  8 Sewage lagoon  11 Fuel storage  Oil well/Gas well  
 3 Watertight sewer lines  6 Seepage pit  9 Feedyard  12 Fertilizer storage  16 Other (specify below)  
 13 Insecticide storage  
 Direction from well? \_\_\_\_\_ How many feet? \_\_\_\_\_

FROM	TO	LITHOLOGIC LOG	FROM	TO	PLUGGING INTERVALS
0	2	SAND	262	295	COARSE SAND
2	6	SANDY CLAY	295	300	SANDY CLAY
6	20	CLAY			
20	46	SANDY CLAY			
46	78	CLAY			
78	90	SAND & SANDY CLAY			
90	102	COARSE SAND			
102	113	CLAY & SANDY CLAY			
113	135	CALICHE CLAY			
135	152	COARSE SAND			
152	159	SANDY CLAY			
159	202	COARSE SAND			
202	210	SAND & SANDY CLAY			
210	240	COARSE SAND			
240	262	COARSE SAND W/SMALL GRAVEL			

7 CONTRACTOR'S OR LANDOWNER'S CERTIFICATION: This water well was  (1) constructed,  (2) reconstructed, or  (3) plugged under my jurisdiction and was completed on (mo/day/year) 03-15-96 and this record is true to the best of my knowledge and belief. Kansas Water Well Contractor's License No. KWCL-430 This Water Well Record was completed on (mo/day/yr) 03-15-96 under the business name of HOWARD DRUG CO. BOX 806 BEAVER, OKLA 73932 by (signature) Howard Drlg Co

INSTRUCTIONS: Use typewriter or ball point pen. PLEASE PRESS FIRMLY and PRINT clearly. Please fill in blanks, underline or circle the correct answers. Send top three copies to Kansas Department of Health and Environment, Bureau of Water, Topeka, Kansas 66620-0001. Telephone: 913-296-5545. Send one to WATER WELL OWNER and retain one for your records.